


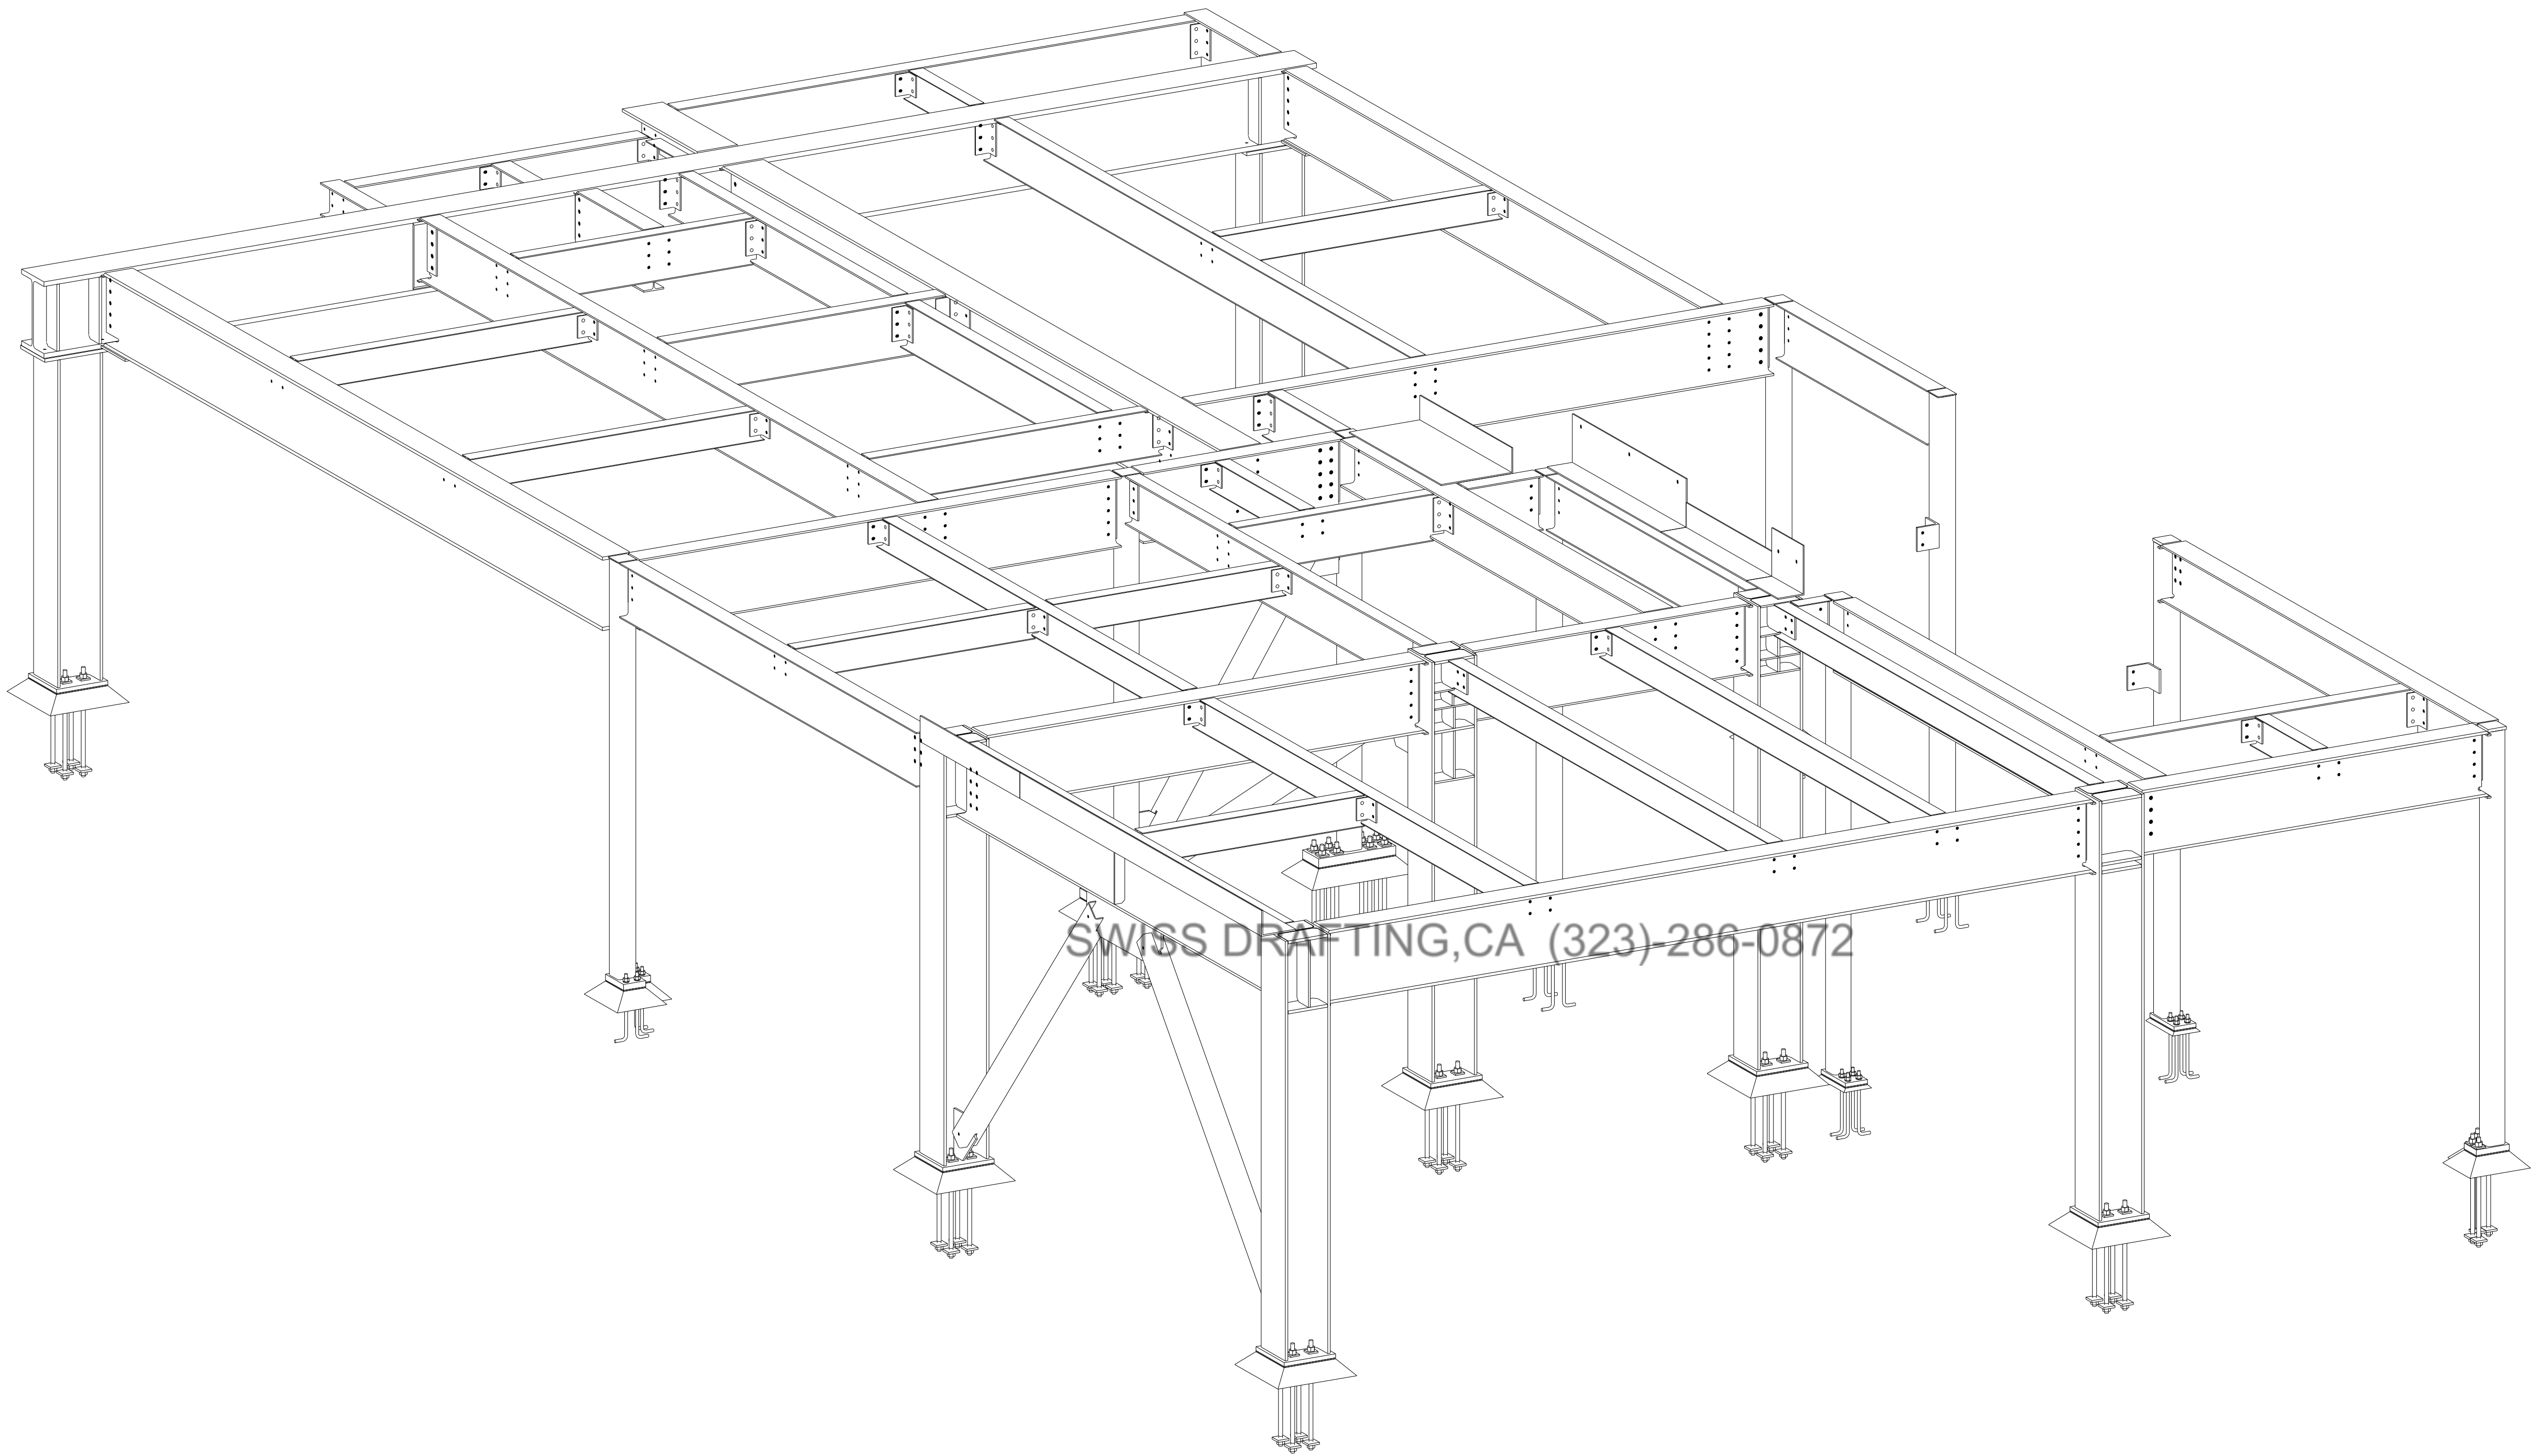

ISOMETRIC VIEW

GA DRAWING INDEX			
DRG.NO.	DESCRIPTION	DATE	REVISION
AB1	ANCHOR BOLT LAYOUT PLAN & DETAILS	12-MARCH-2023	2
E0	INDEX PAGE	12-MARCH-2023	2
E1	SECOND FLOOR FRAMING PLAN & SECTIONS	12-MARCH-2023	2
E2	BRACE DETAILS	12-MARCH-2023	2
E3	MOMENR FRAME SECTIONS	12-MARCH-2023	2

2	03/12/2024	REVISED PER UPDATED SKS DATED 02/21/24
1	02/20/2024	REVISED PER MARKUPS DATED 01/26/24
0	12/21/2023	ISSUED FOR FIELD USE
B	12/08/2023	REVISED & REISSUED FOR APPROVAL PER MARKUPS
A	11/06/2023	ISSUED FOR APPROVAL

PROJECT NAME & LOCATION


22 WHITE STREET RESIDENCES
22 WHITE STREET CAMBRIDGE,MA

DWG. TITLE:
INDEX PAGE

ENGINEER:
ARCHITECT: KHALSA DESIGN INC.


CONTRACTOR:				
DRAWN BY: RH	CHK'D BY: AS	JOB NUMBER	DWG. NO.	REVISION
DATE: 11/05/2023	DATE: 11/05/2023	---	E0	2

FINISH: AS PER SPEC.
BOLT: A325N
HOLE SIZE: 13/16 DIA. U/N
MATERIAL:
W SHAPES: A992-50
PIPS: A53, Gr. B
HSS SHAPES: A500, Gr. B
PLATES/CHANNELS: A36

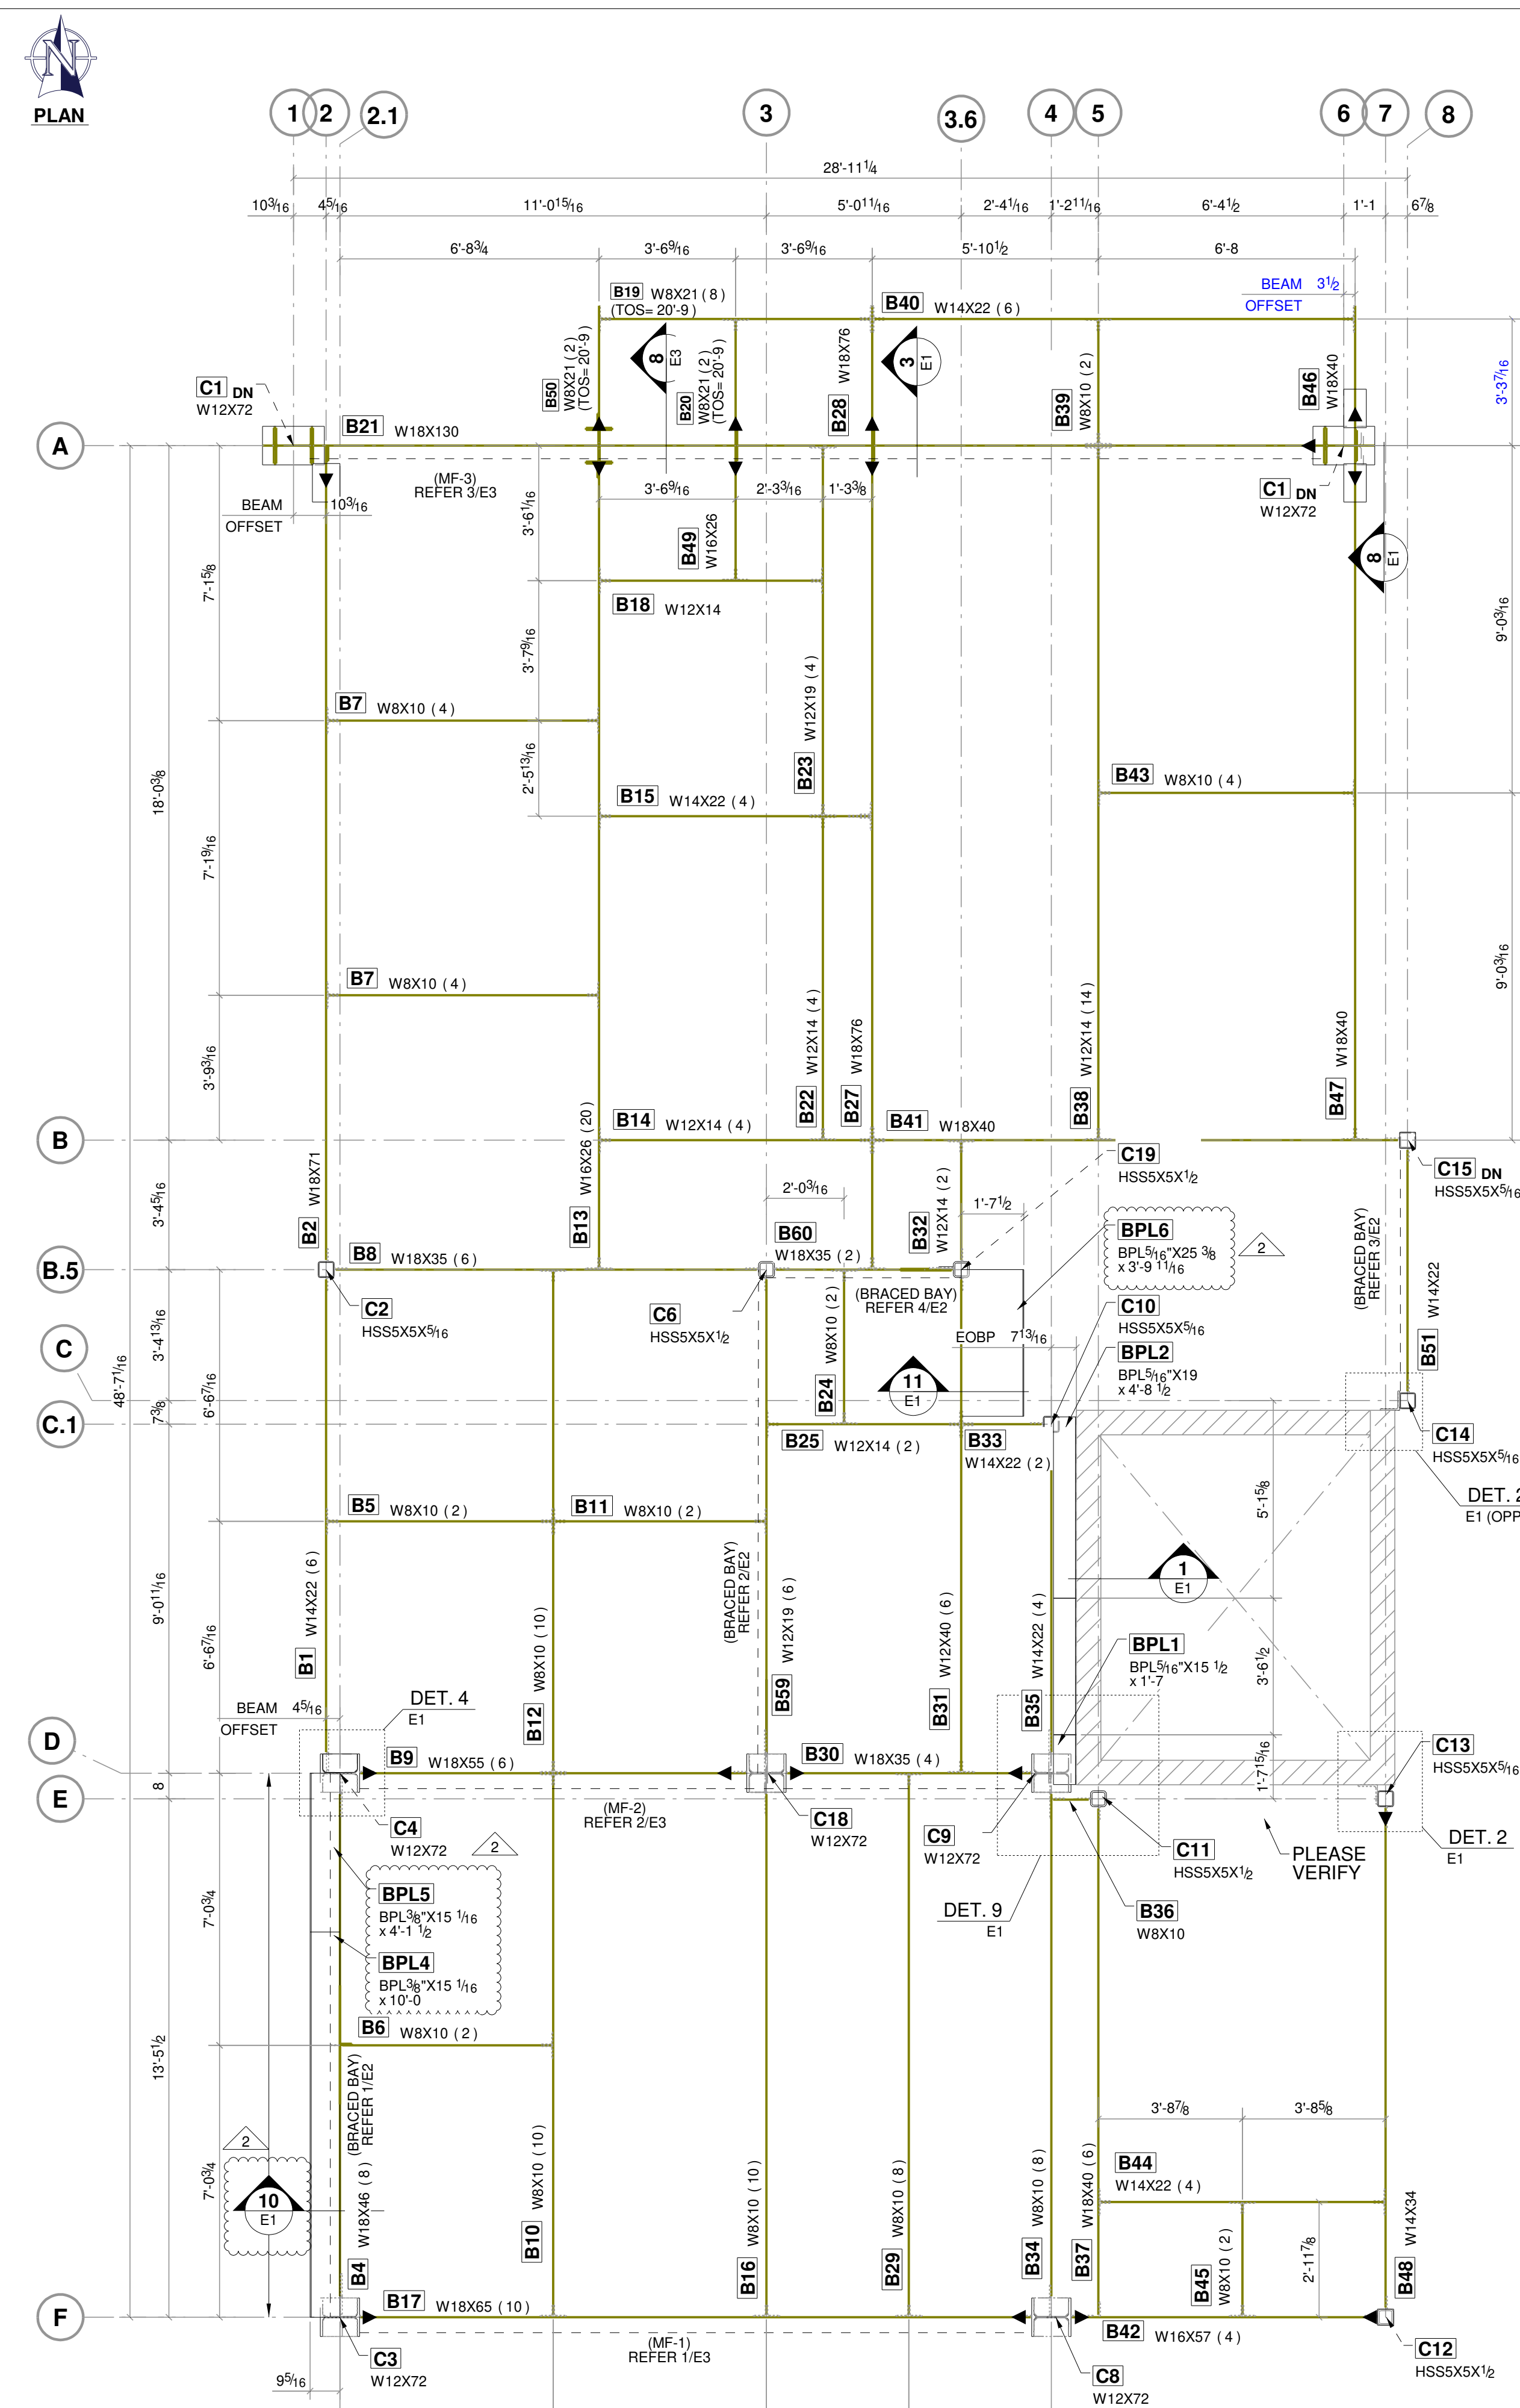


1 SECOND FLOOR FRAMING PLAN
REF: S-101


- GENERAL NOTES:**
- DATUM LEVEL = FINISH FLOOR = 12'-0"
 - ALL ELEVATIONS ARE GIVEN FROM DATUM EL.
 - TOP OF STEEL ELEVATION = 21'-2 1/2" (UNO)

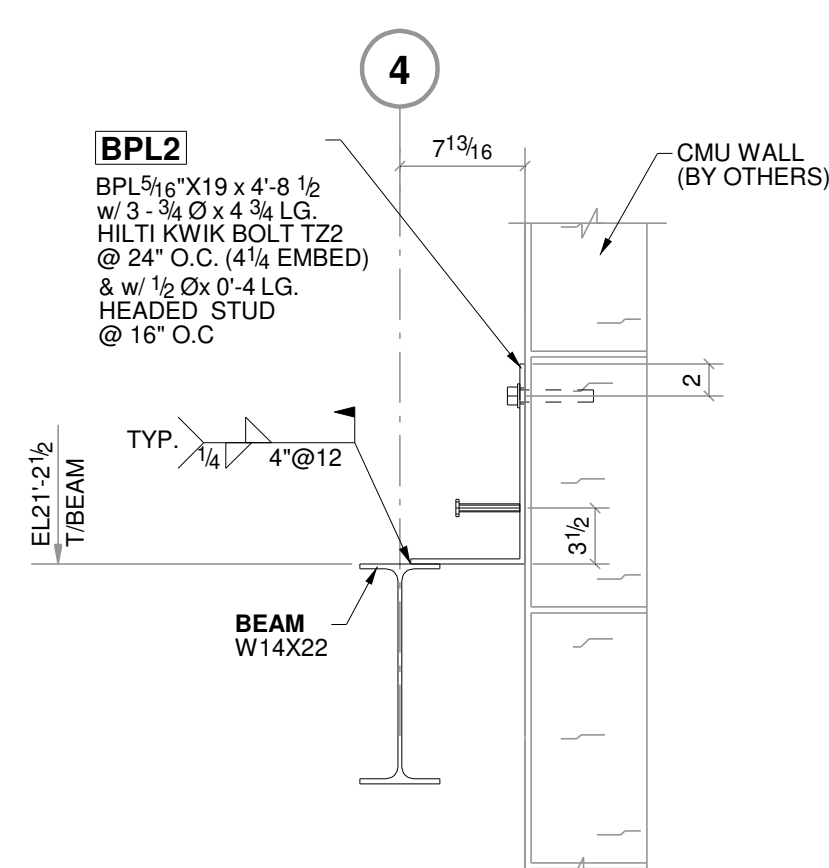


1 SECTION
REF.: 5/S-005

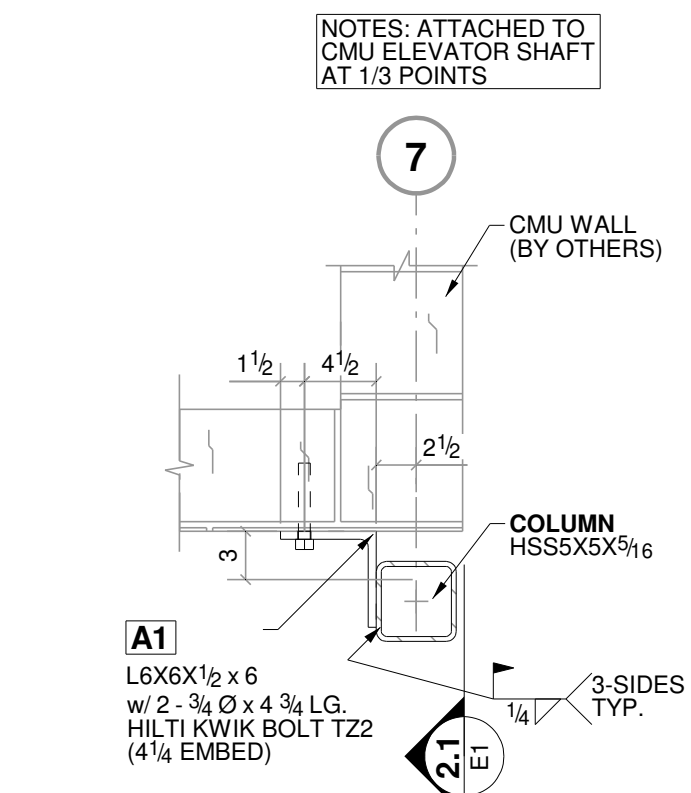


2 DETAIL

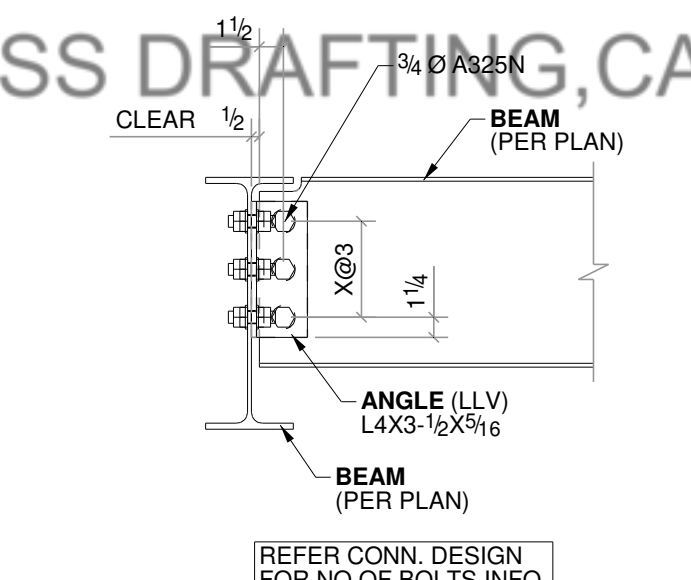


5 TYPICAL BEAM TO BEAM CONNECTION DETAILS

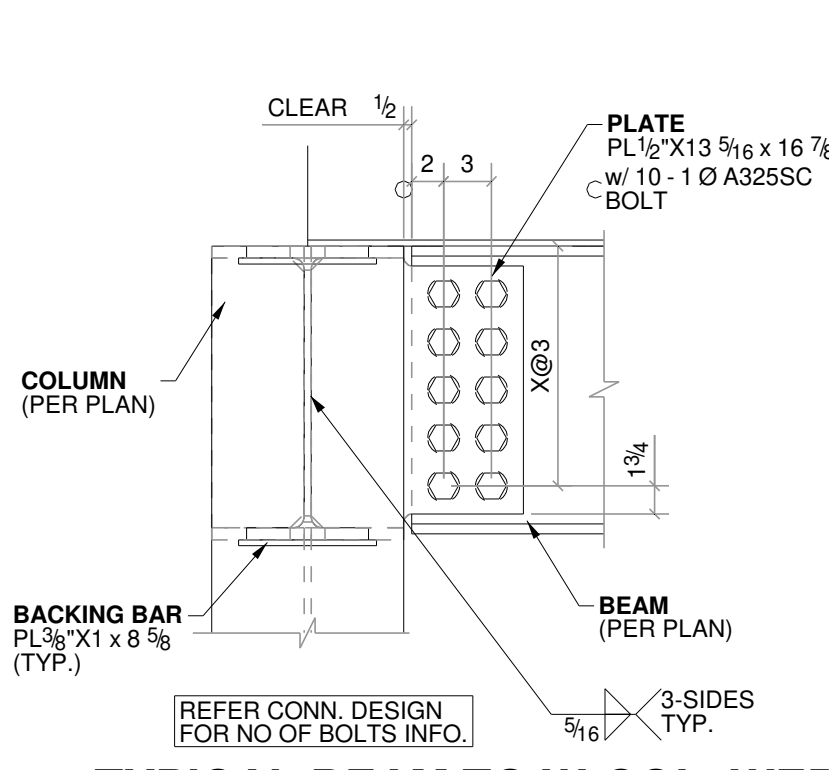


7 TYPICAL BEAM TO W-COL. WEB CONNECTION DETAILS

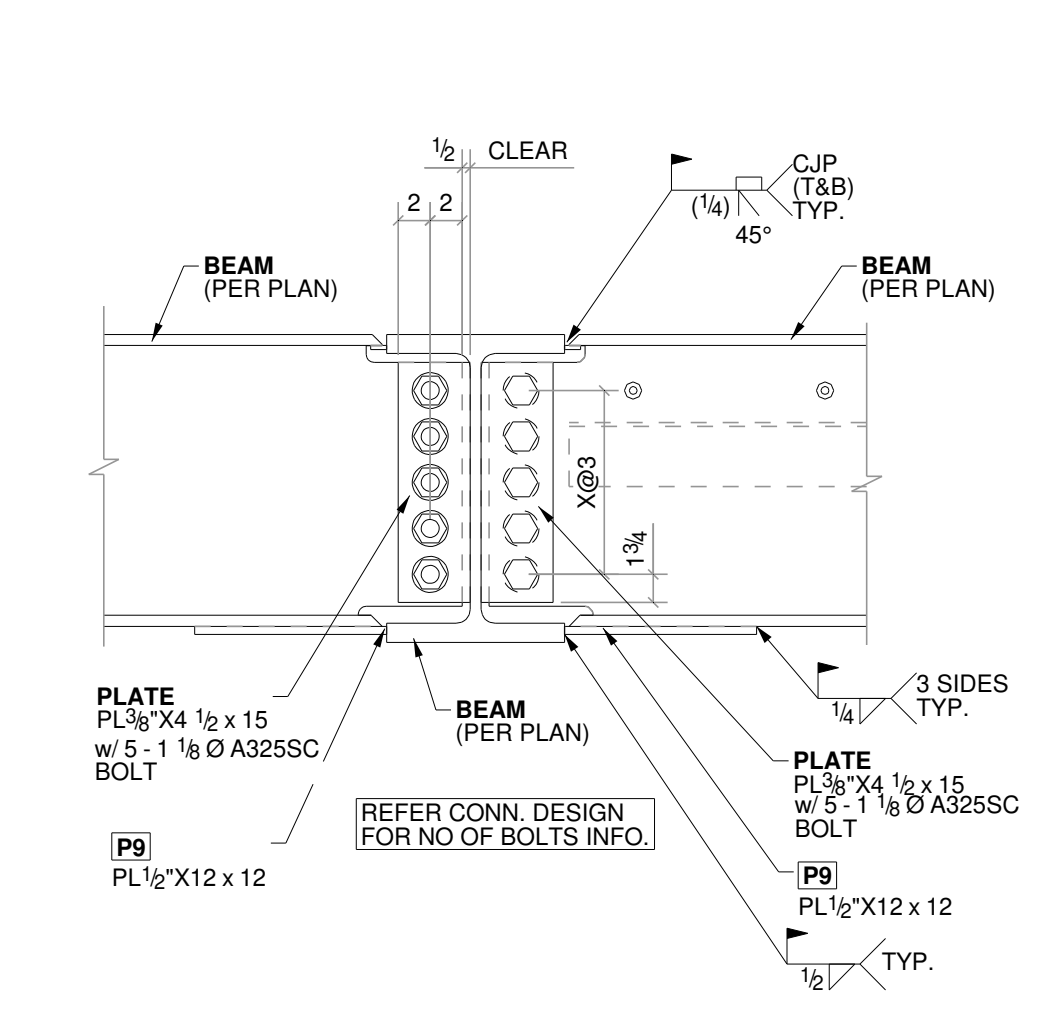


3 SECTION
REF.: 11/S-003

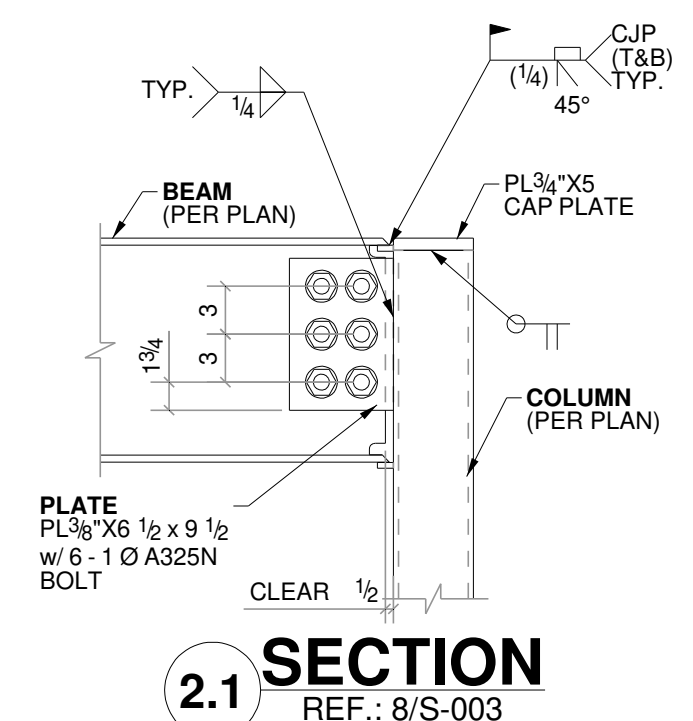


2.1 SECTION
REF.: 8/S-003

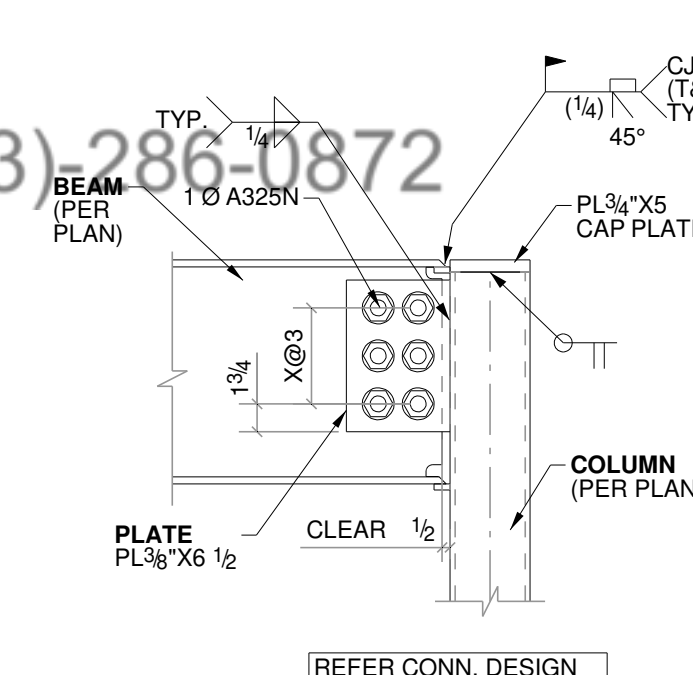


6 TYPICAL BEAM TO HSS COL. CONNECTION DETAILS

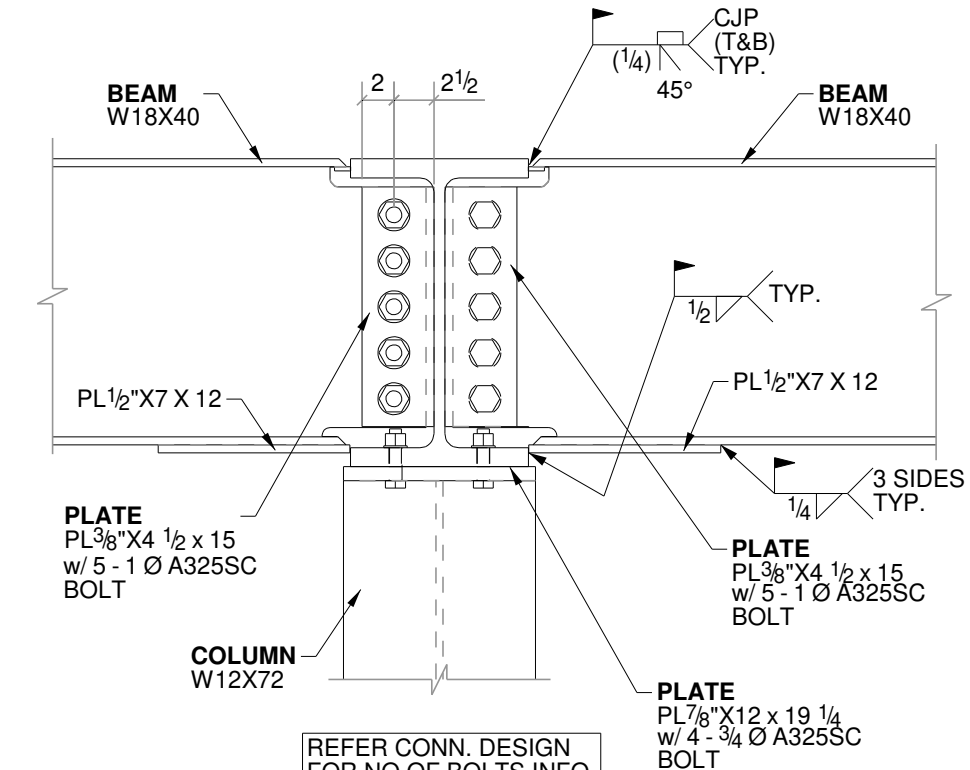


8 SECTION

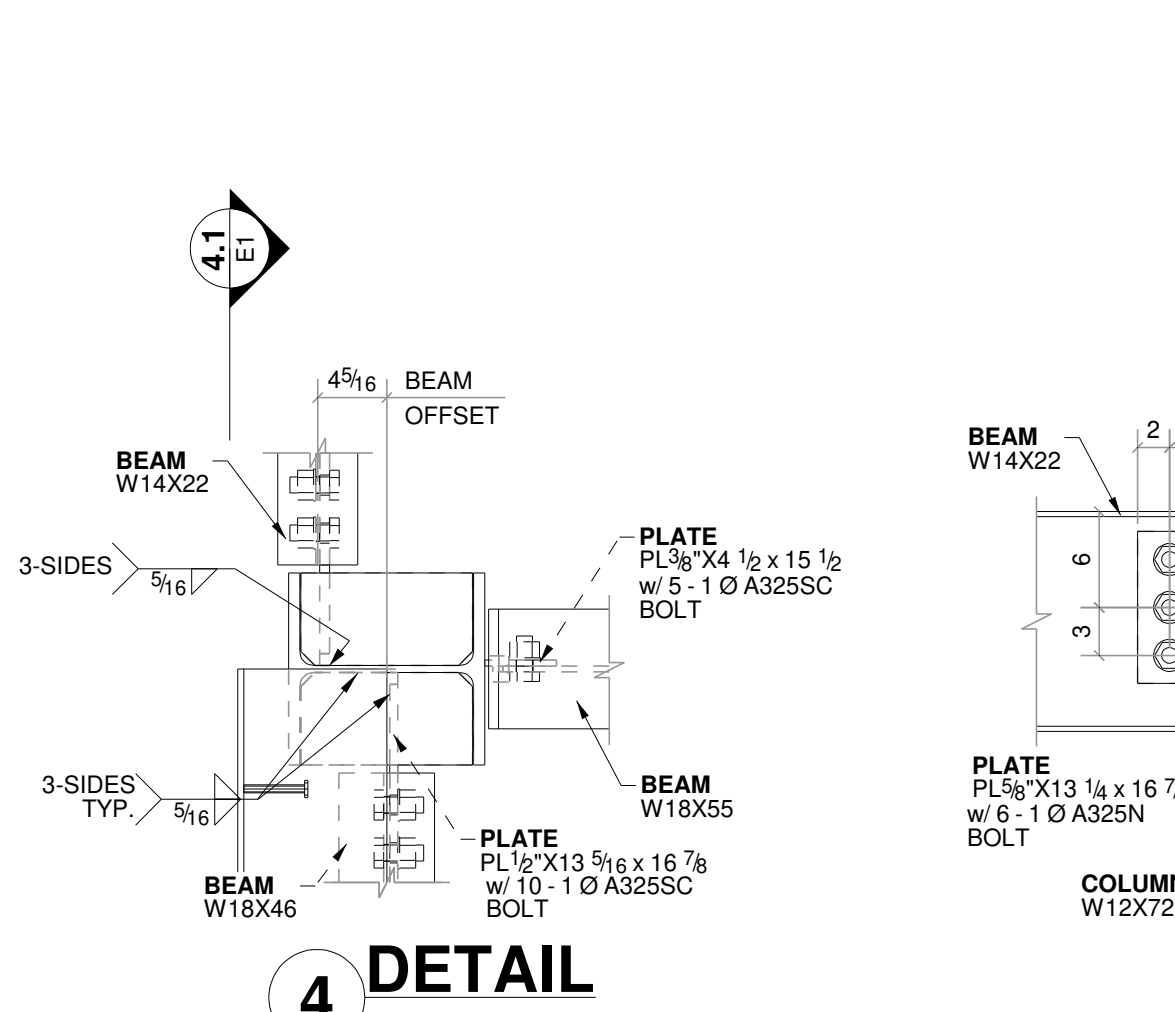


4 DETAIL

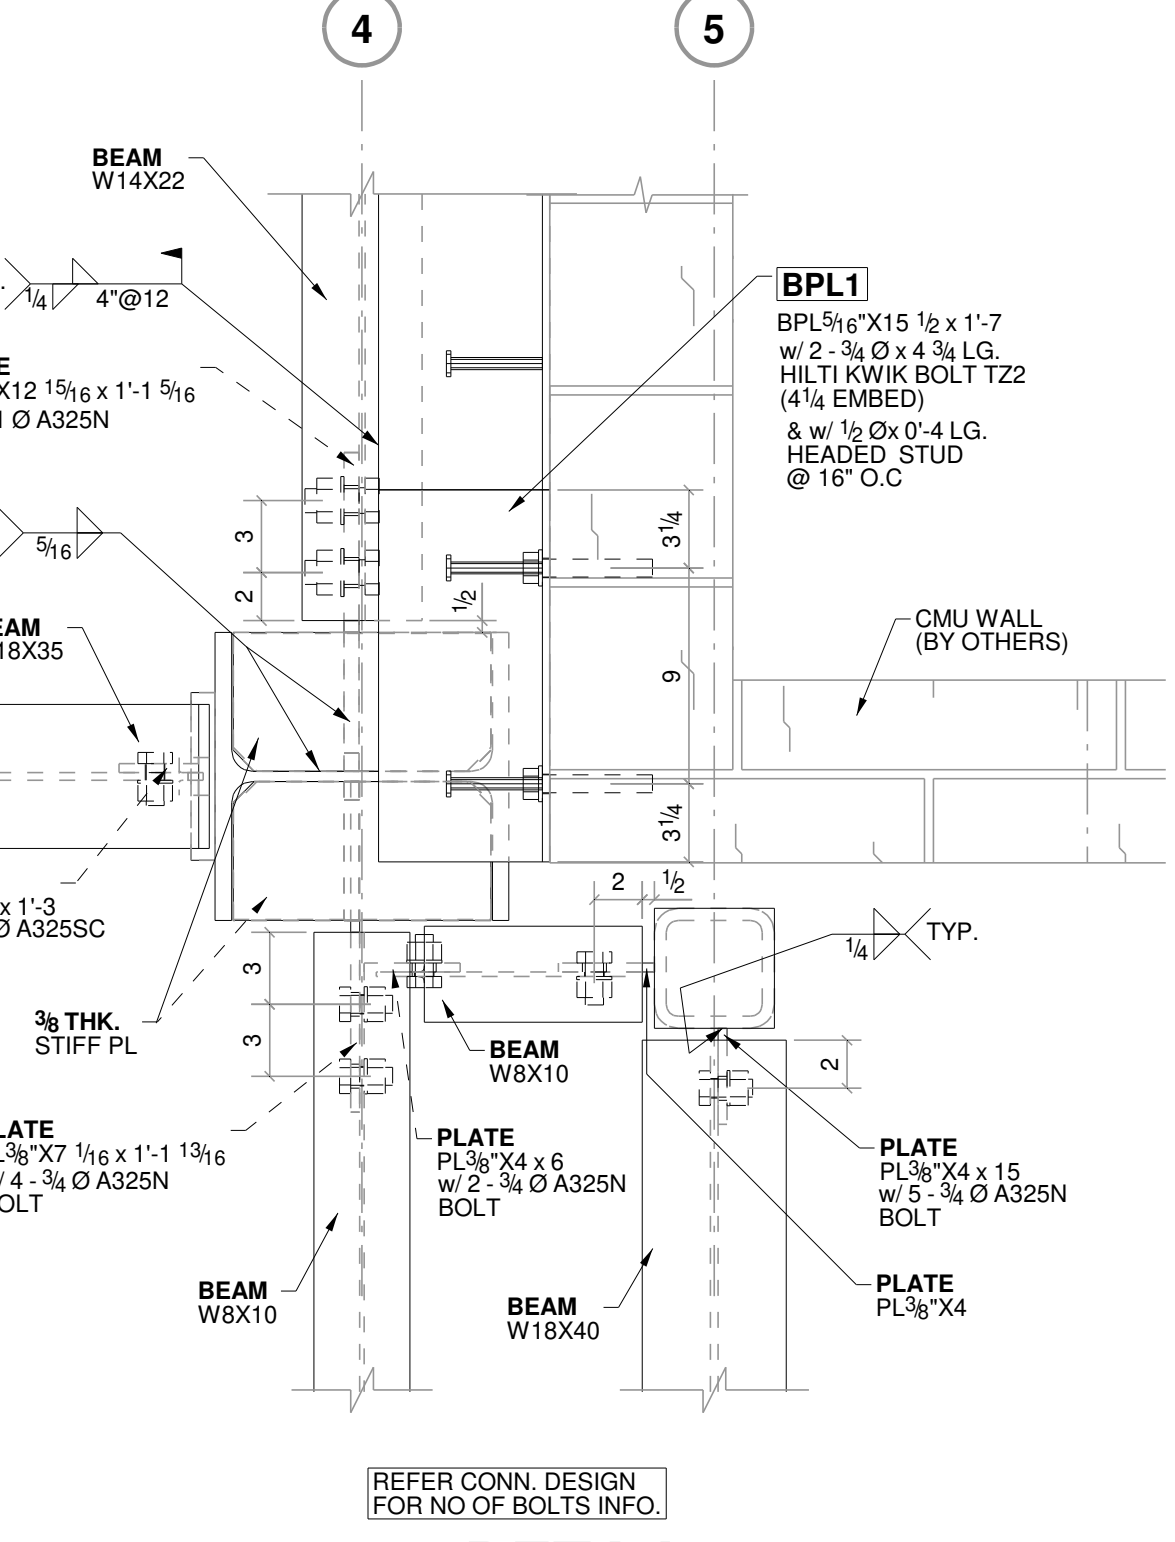


9 DETAIL

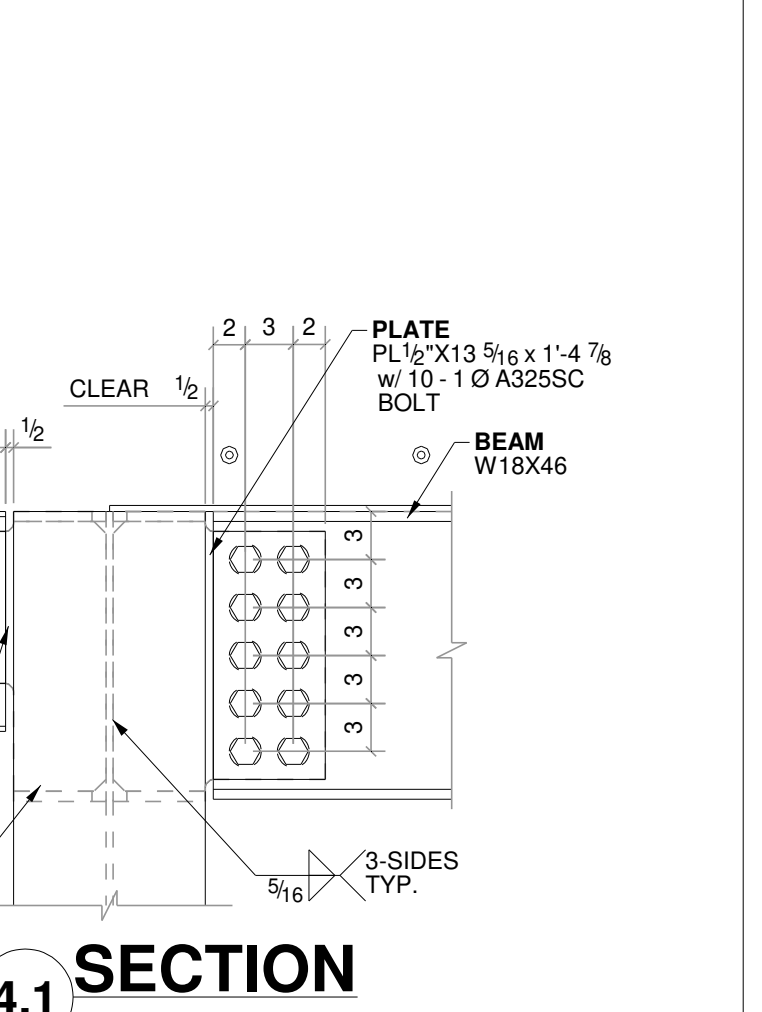

4.1 SECTION

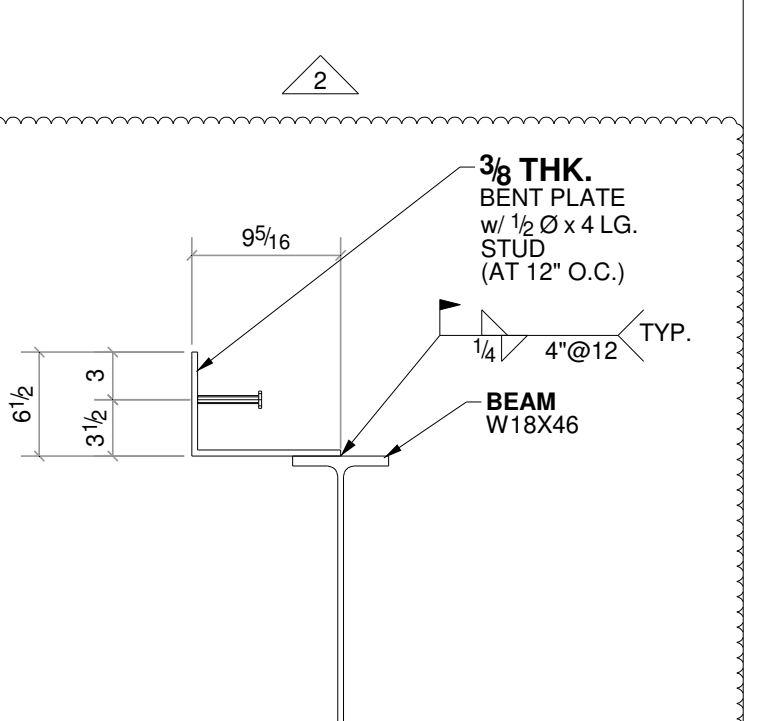

10 SECTION
REF.: 11/S-302

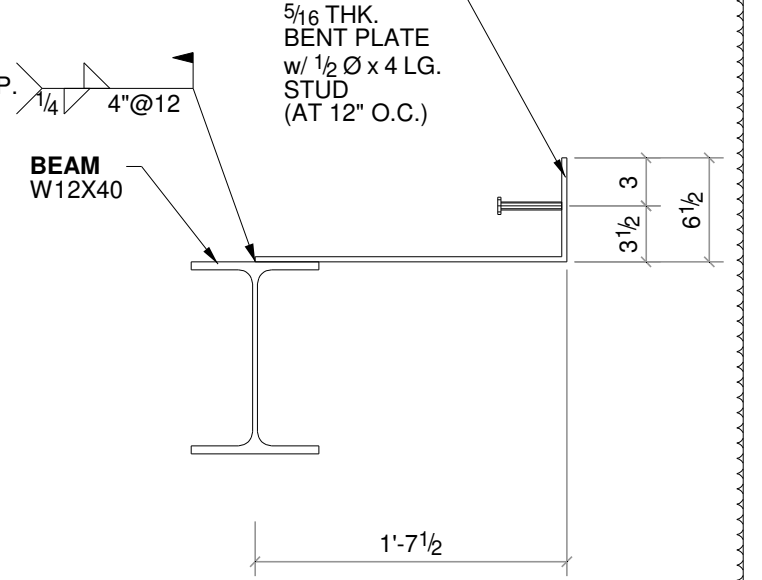

11 SECTION
REF.: 12/S-302

2	03/12/2024	REVISED PER UPDATED SKS DATED 02/21/24
1	02/20/2024	REVISED PER MARKUPS DATED 01/26/24
0	12/21/2023	ISSUED FOR FIELD USE
B	12/08/2023	REVISED & REISSUED FOR APPROVAL PER MARKUPS
A	11/06/2023	ISSUED FOR APPROVAL




PROJECT NAME & LOCATION
22 WHITE STREET RESIDENCES
22 WHITE STREET CAMBRIDGE, MA

DWG. TITLE:
SECOND FLOOR FRAMING PLAN & SECTIONS

ENGINEER:
ARCHITECT: **KHALSA DESIGN INC.**

CONTRACTOR:	DRAWN BY: RH	CHK'D BY: AS	JOB NUMBER	DWG. NO.	REVISION
DATE: 10/29/2023	DATE: 11/03/2023	---	---	E1	2

FINISH: AS PER SPEC.
BOLT: A325N
HOLE SIZE: 13/16 DIA. UN
MATERIAL:
W SHAPES: A992-50
HSS SHAPES: A500, Gr. B
PLATES/CHANNELS: A36

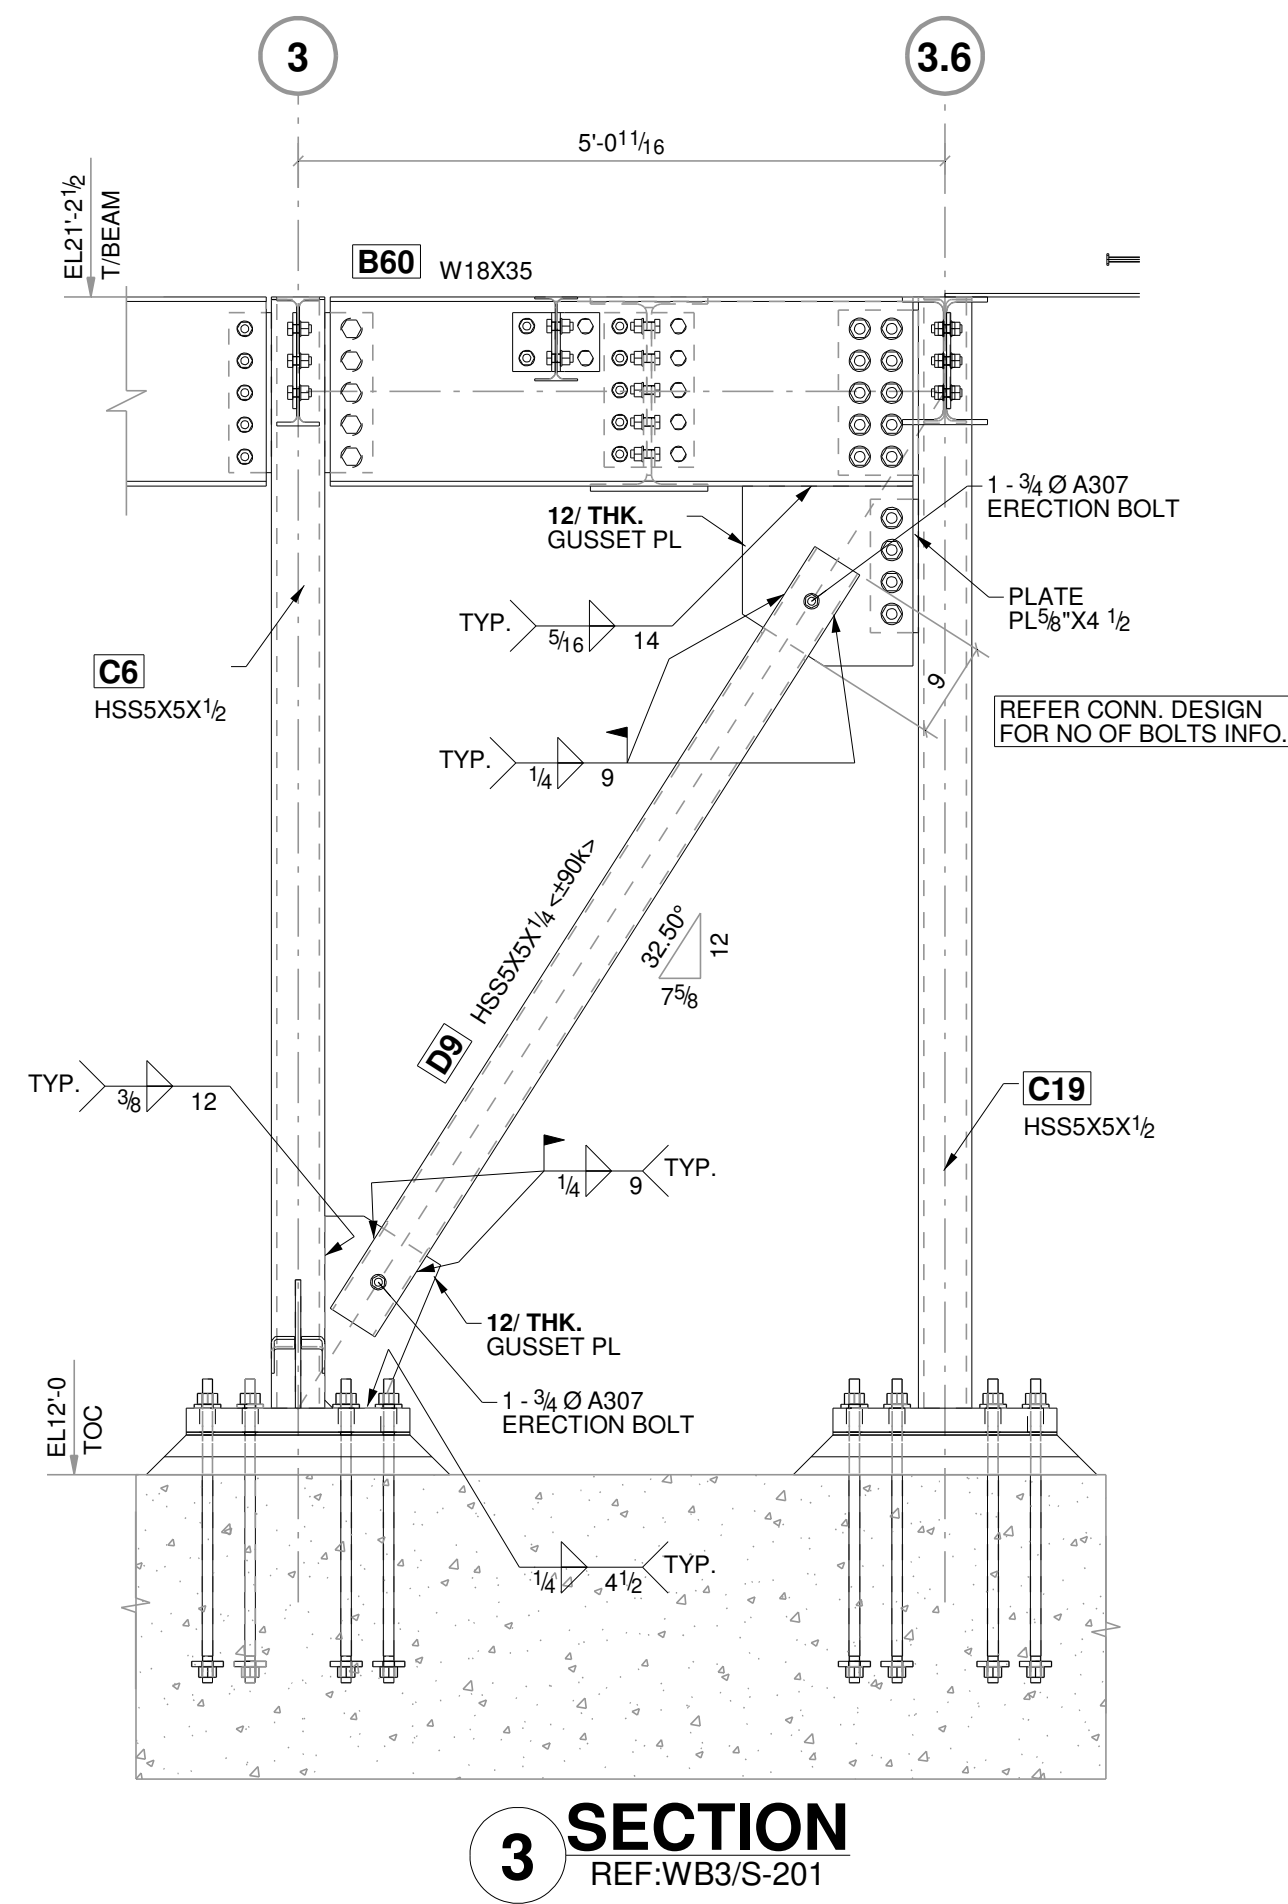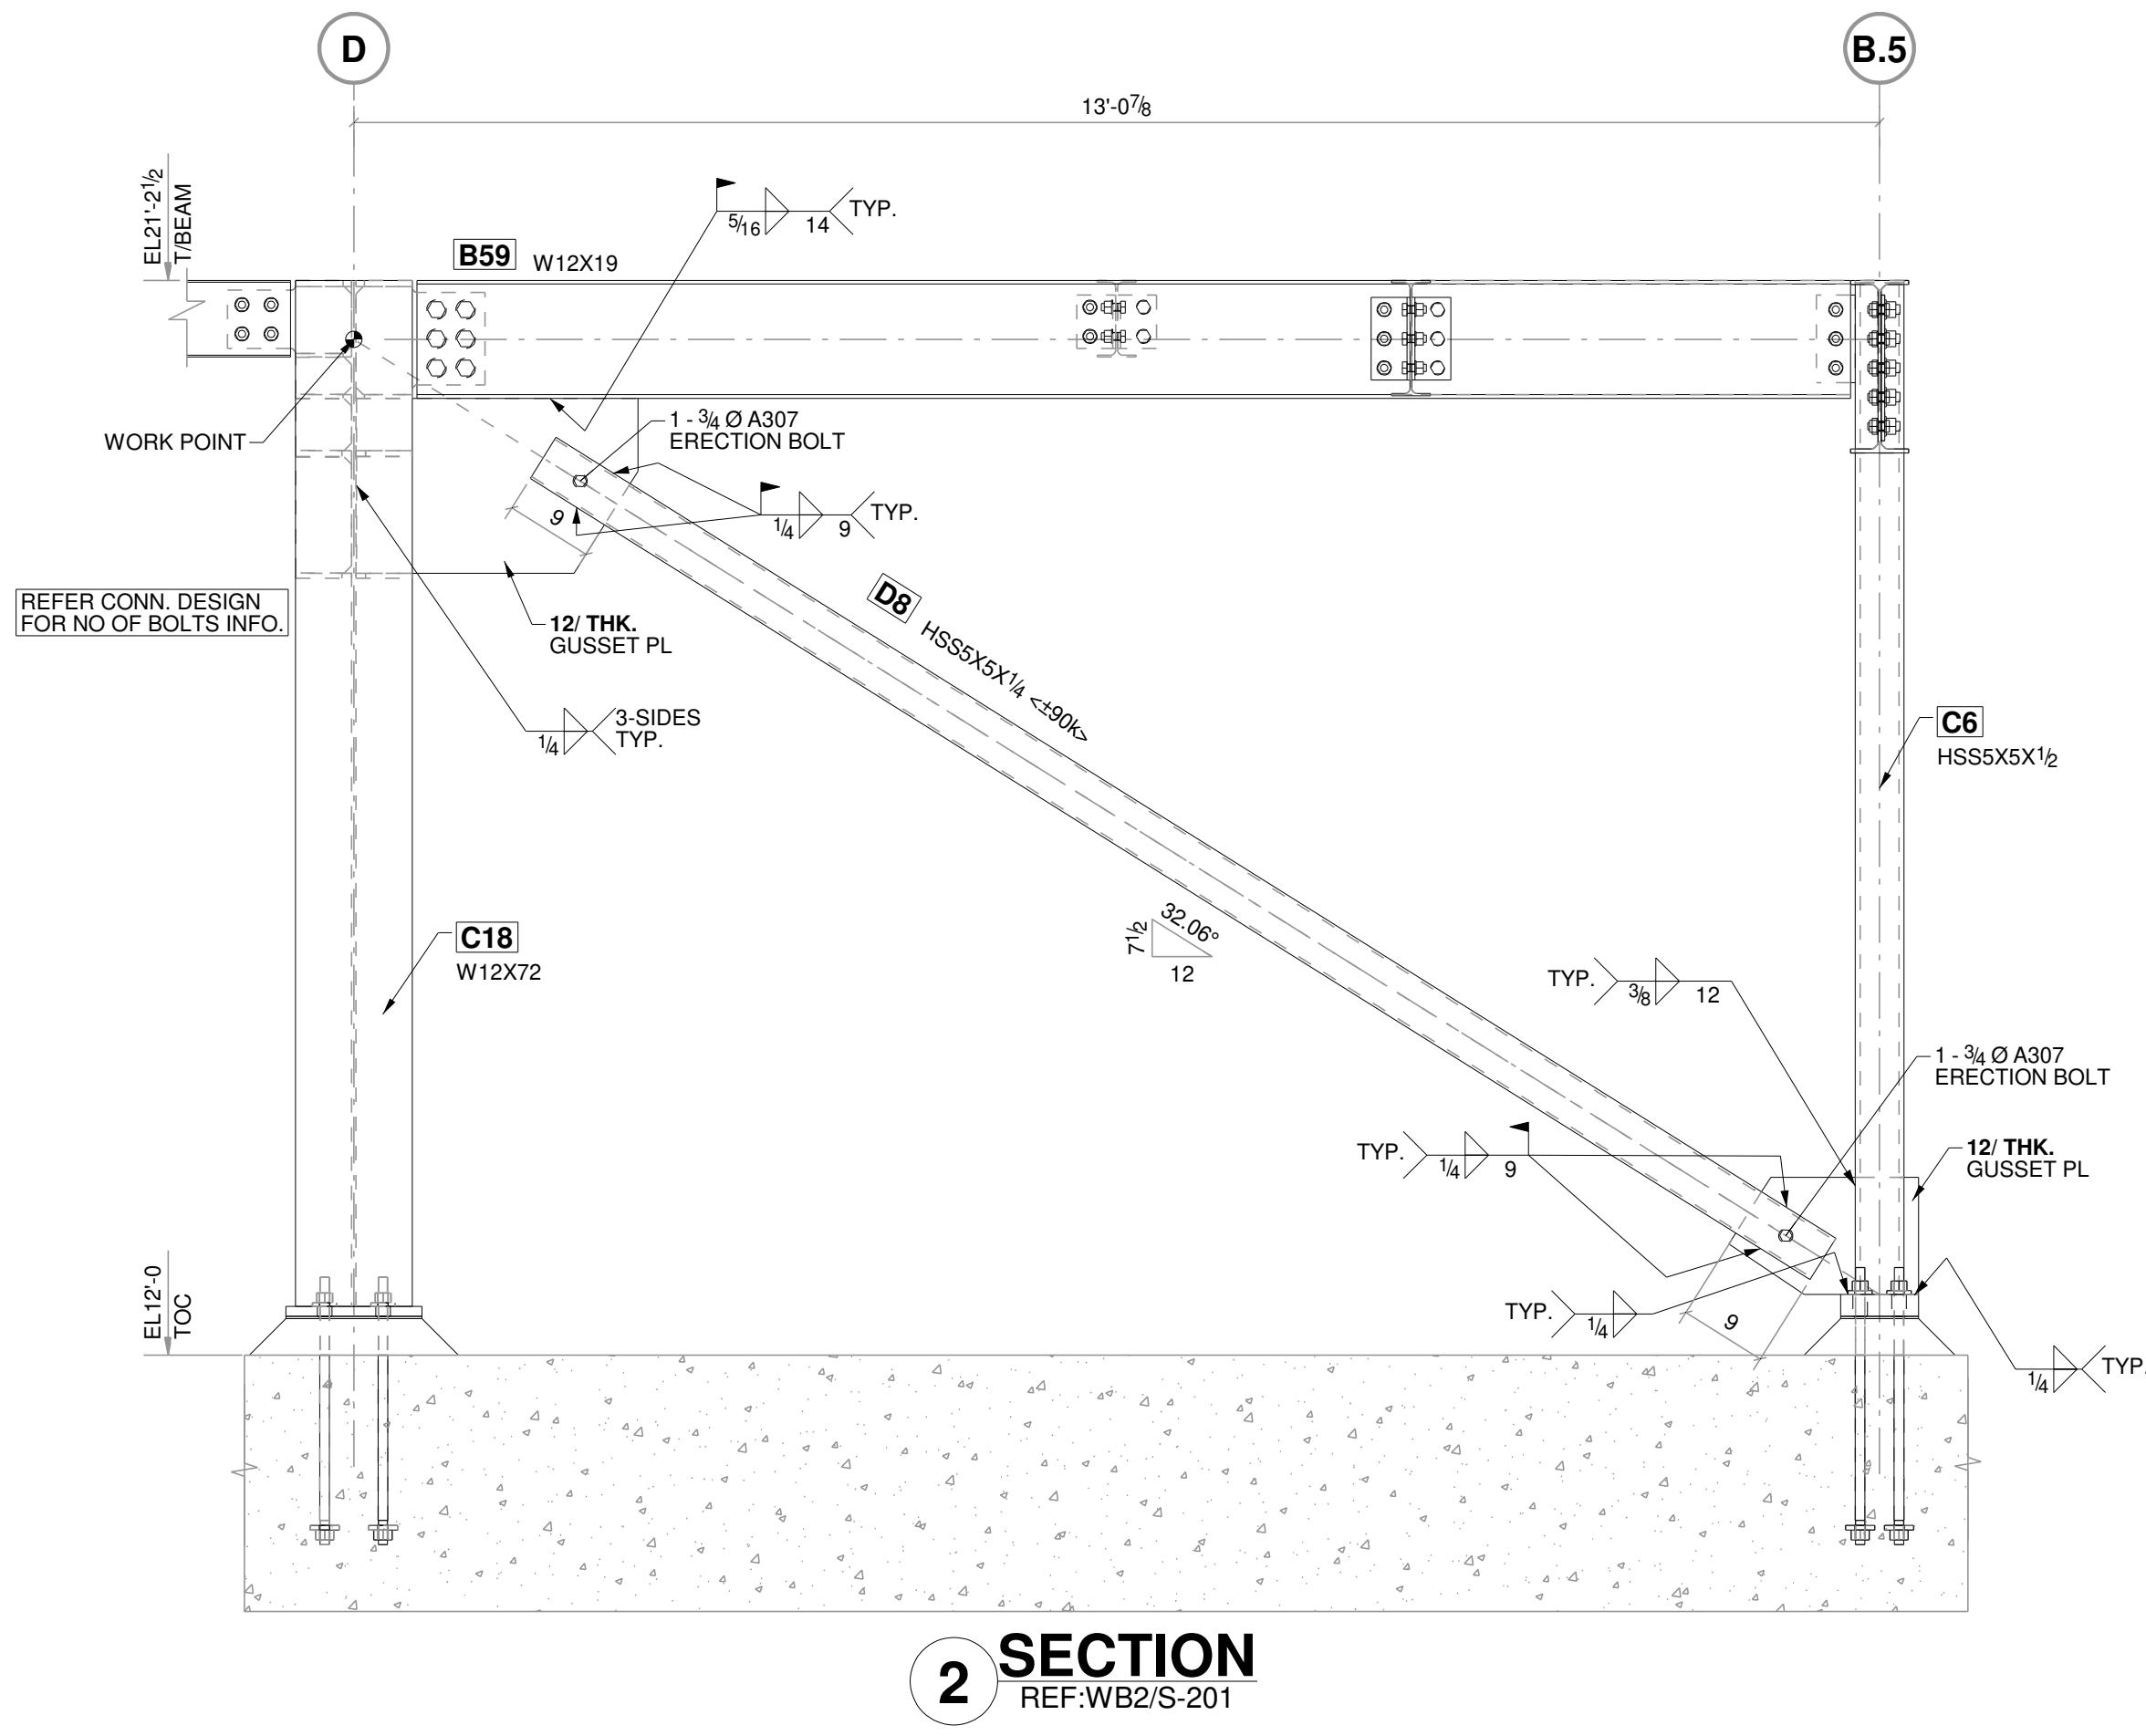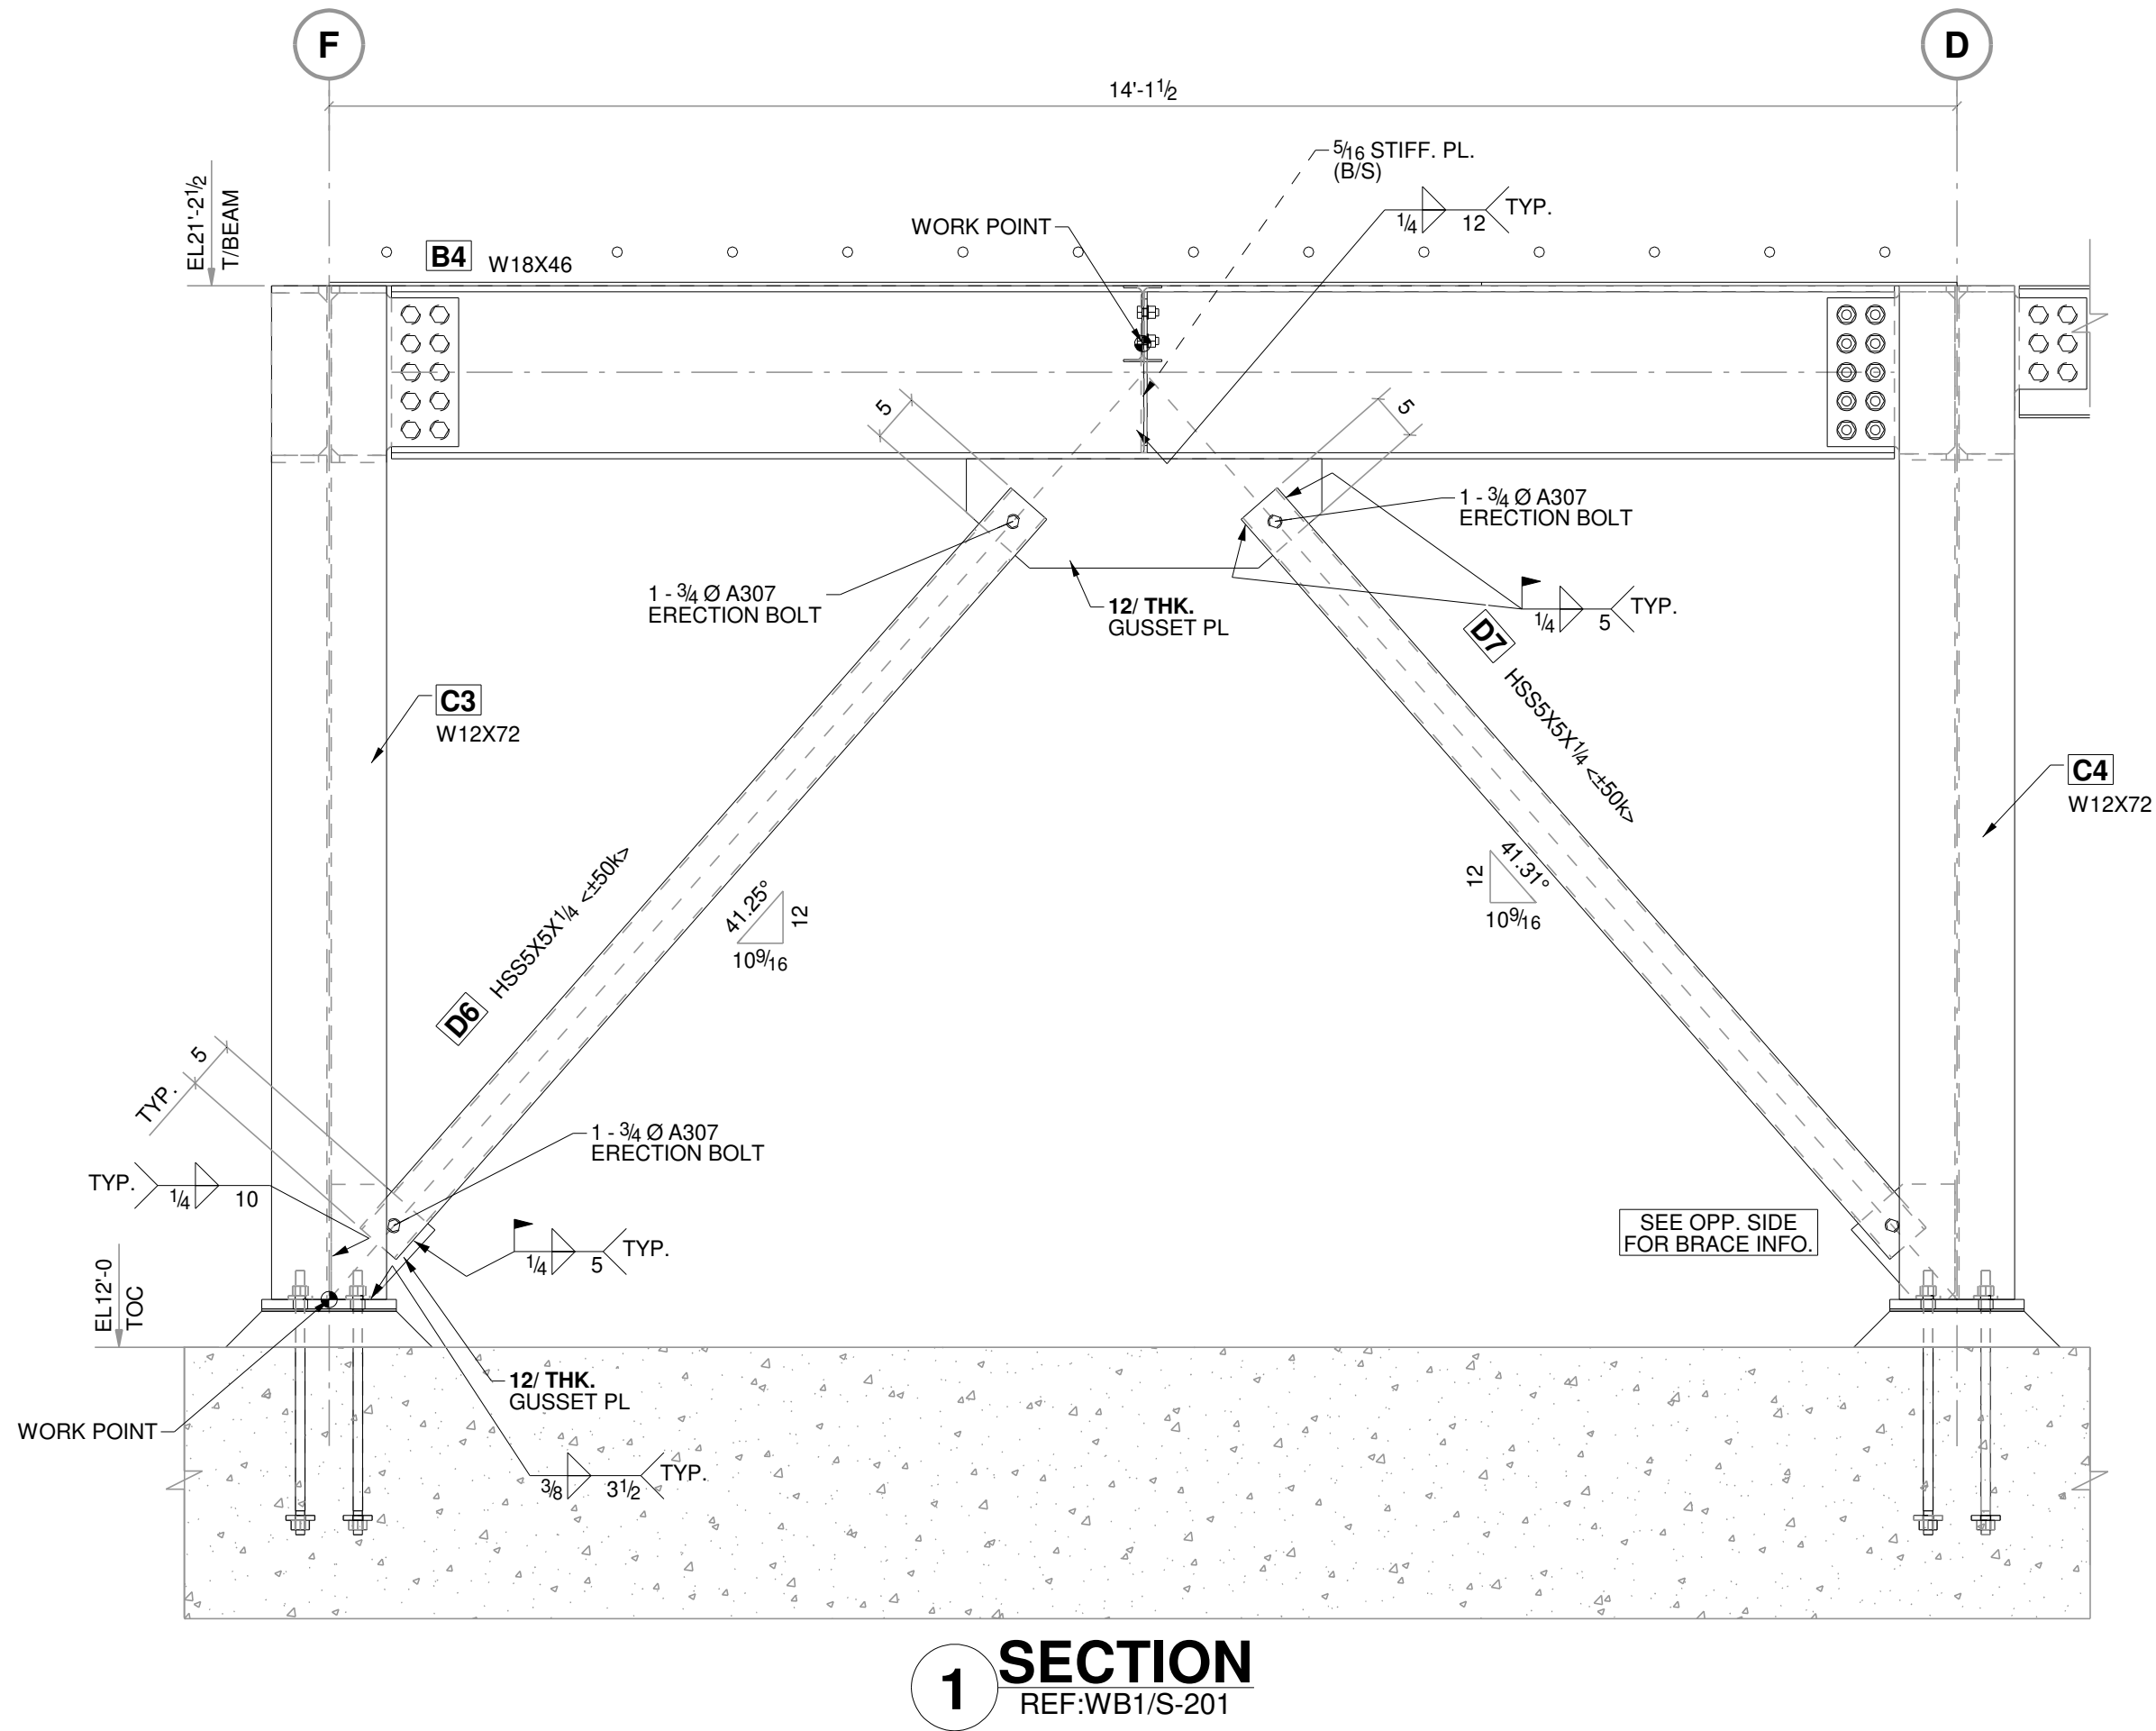


SWISS DRAFTING,CA (323)-286-0872

2	03/12/2024	REVISED PER UPDATED SKS DATED 02/21/24
1	02/20/2024	REVISED PER MARKUPS DATED 01/26/24
0	12/21/2023	ISSUED FOR FIELD USE
B	12/08/2023	REVISED & REISSUED FOR APPROVAL PER MARKUPS
A	11/06/2023	ISSUED FOR APPROVAL


PROJECT NAME & LOCATION
22 WHITE STREET RESIDENCES
22 WHITE STREET CAMBRIDGE,MA

DWG. TITLE:
BRACE DETAILS


FINISH:	AS PER SPEC.	ENGINEER:	
BOLT:	A325N	ARCHITECT:	KHALSA DESIGN INC.
HOLE SIZE:	13/16 DIA. U/N	CONTRACTOR:	
MATERIAL:	W SHAPES: A992-50 PIPS: A53, Gr. B HSS SHAPES: A500, Gr. B PLATES/CHANNELS: A36	DRAWN BY: RH	CHK'D BY: AS
		DATE: 10/29/2023	DATE: 11/03/2023
		JOB NUMBER	DWG. NO.
		---	E2
		REVISION	2

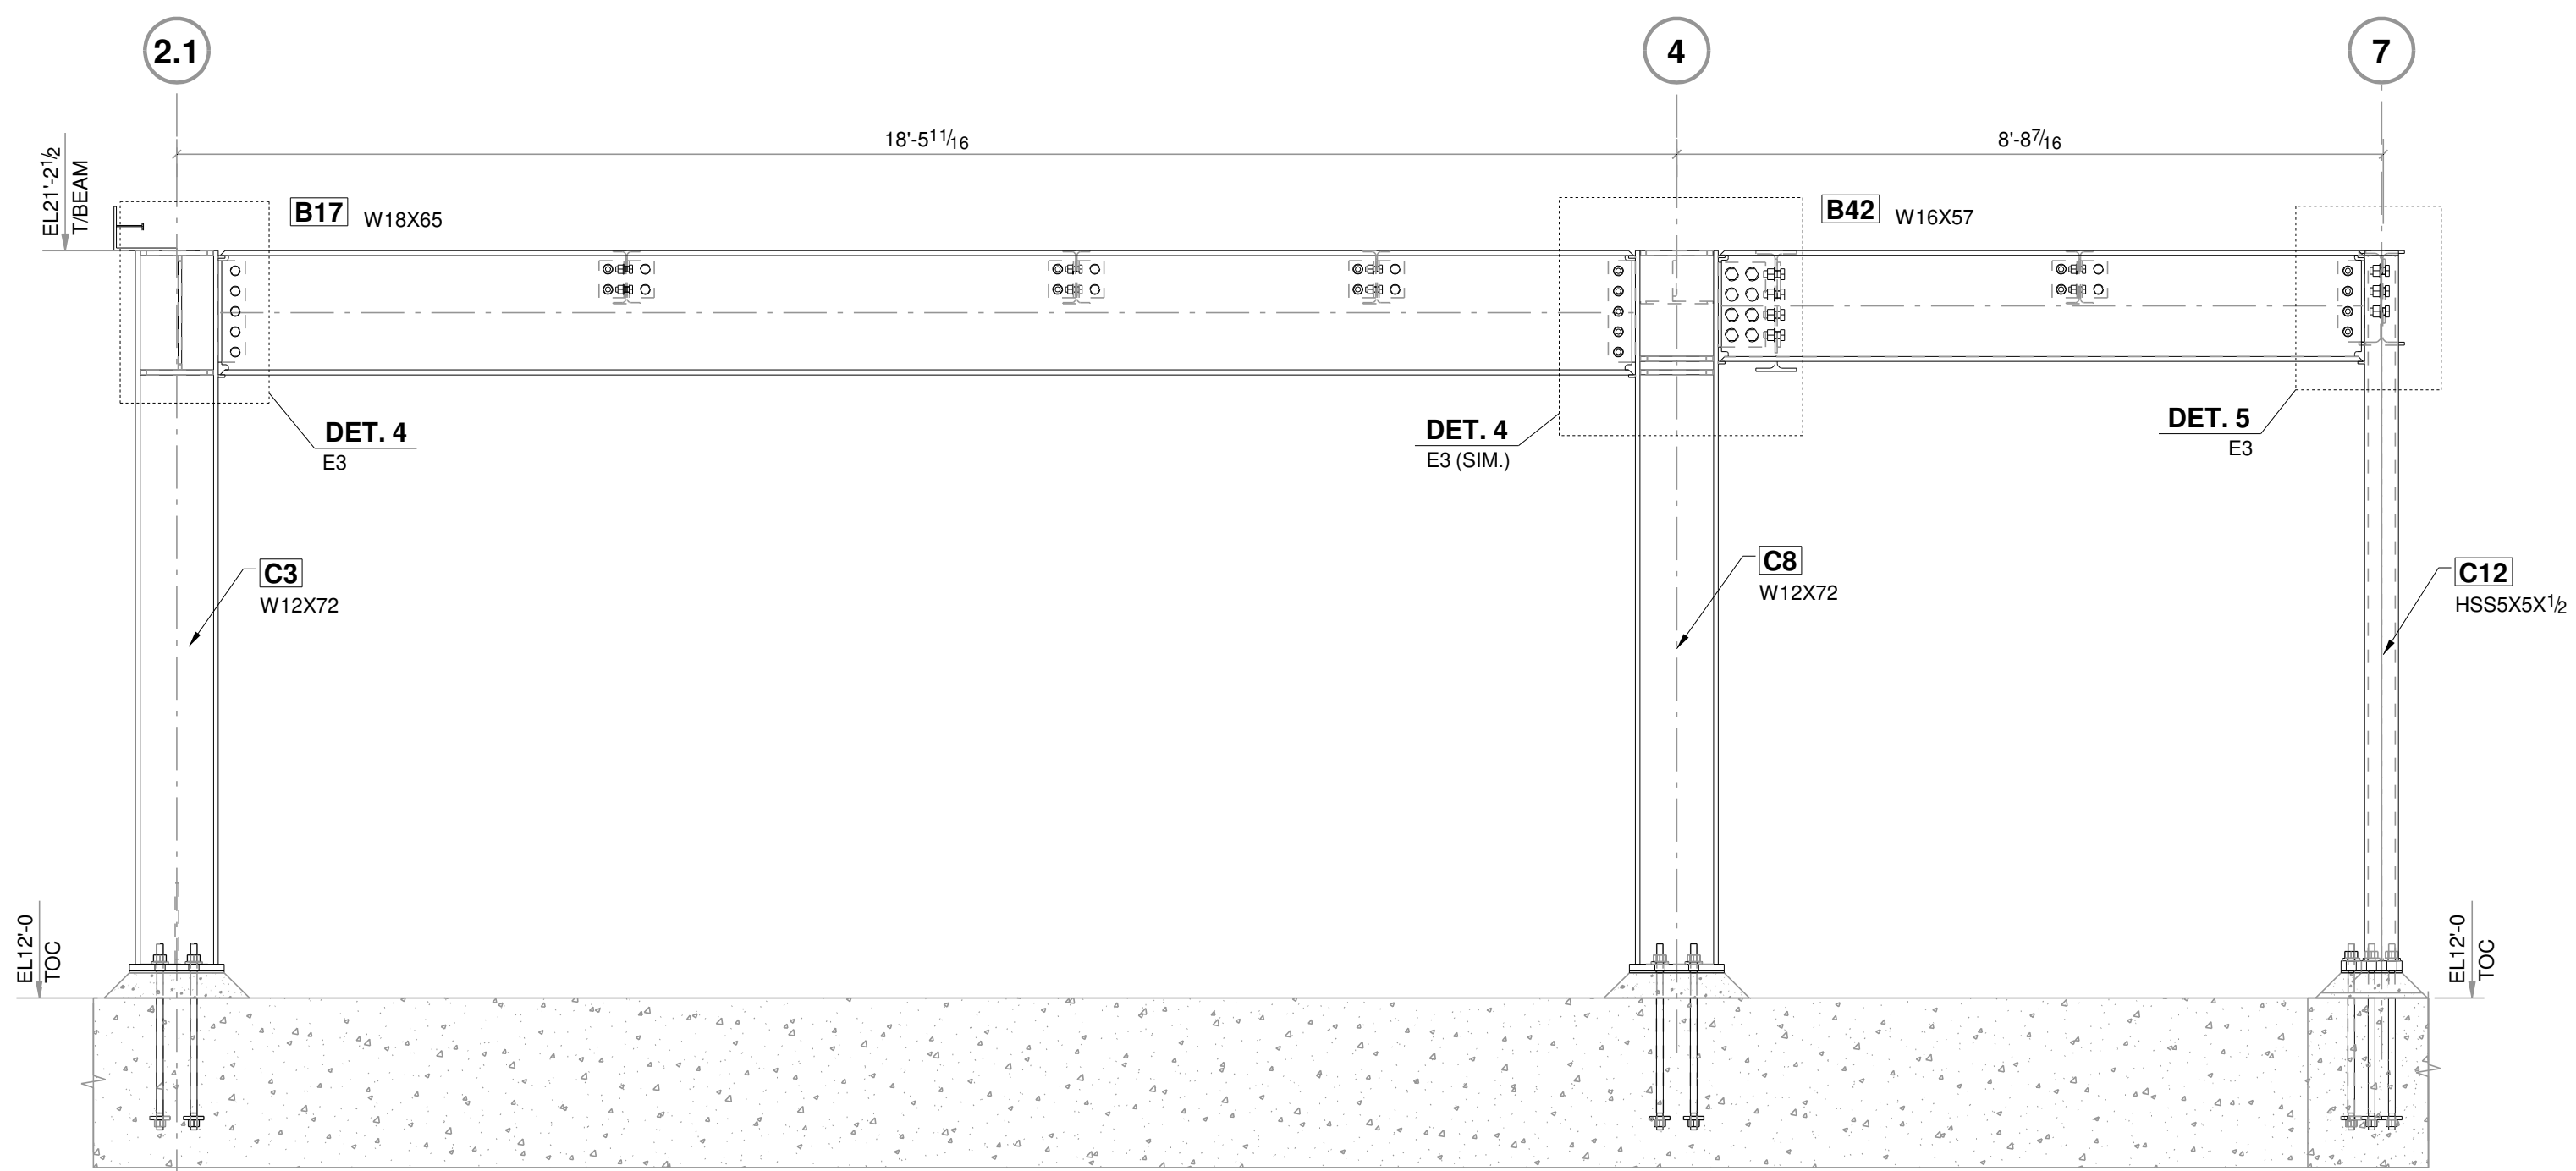


1 SECTION
REF: MF1/S201

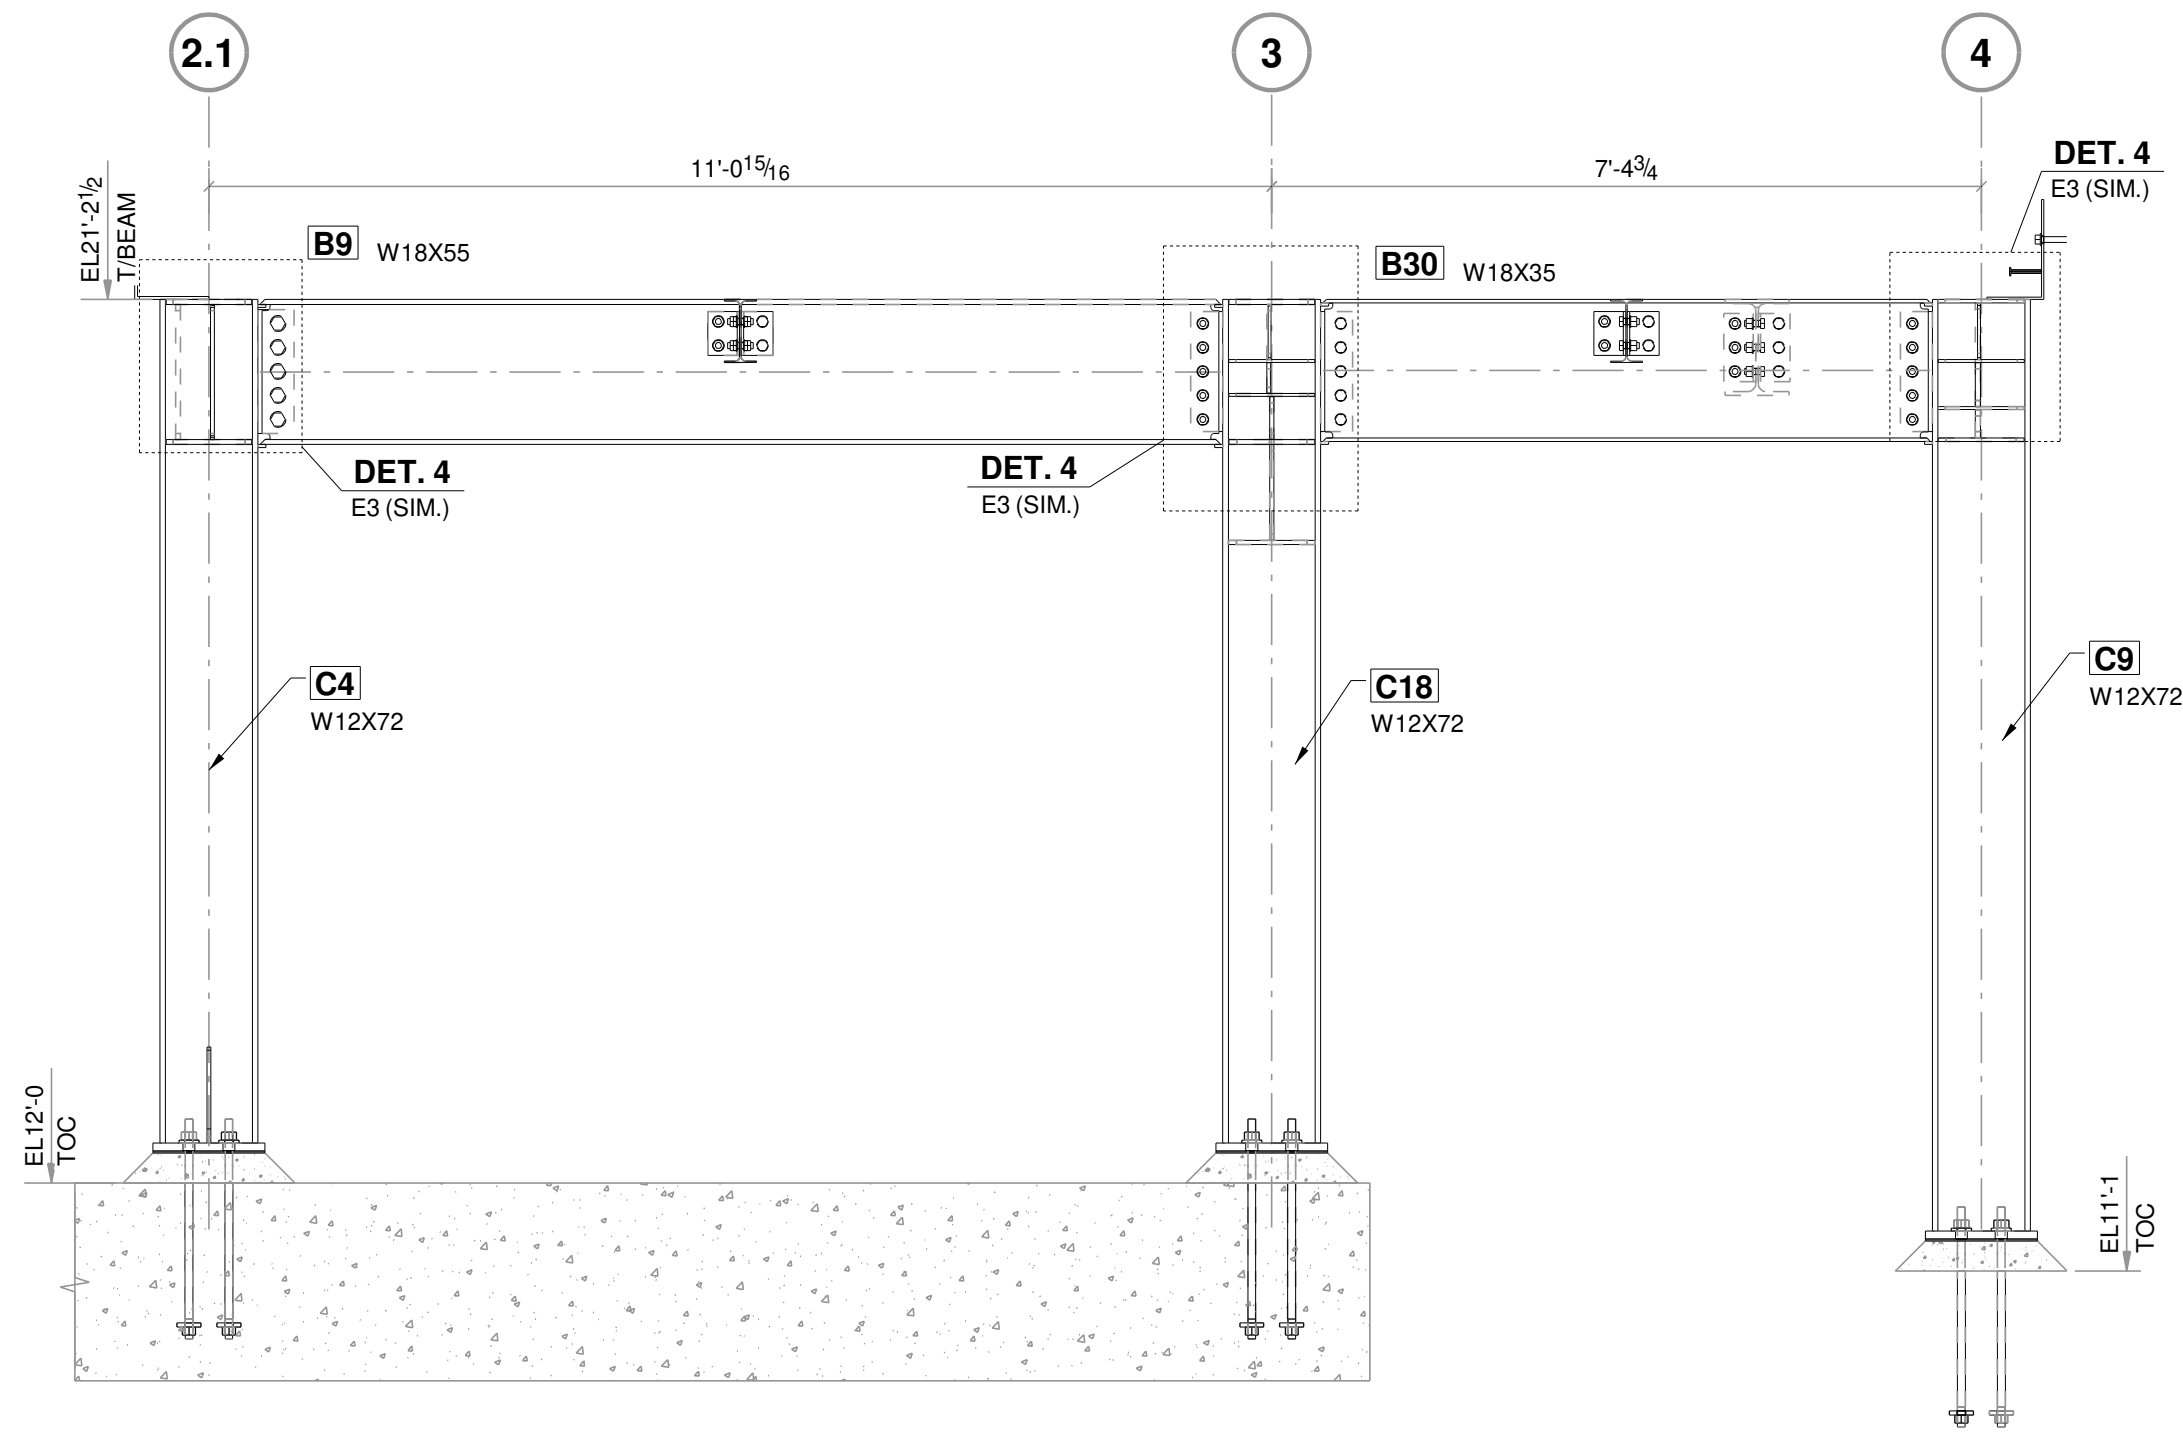

2 SECTION
REF: MF2/S201

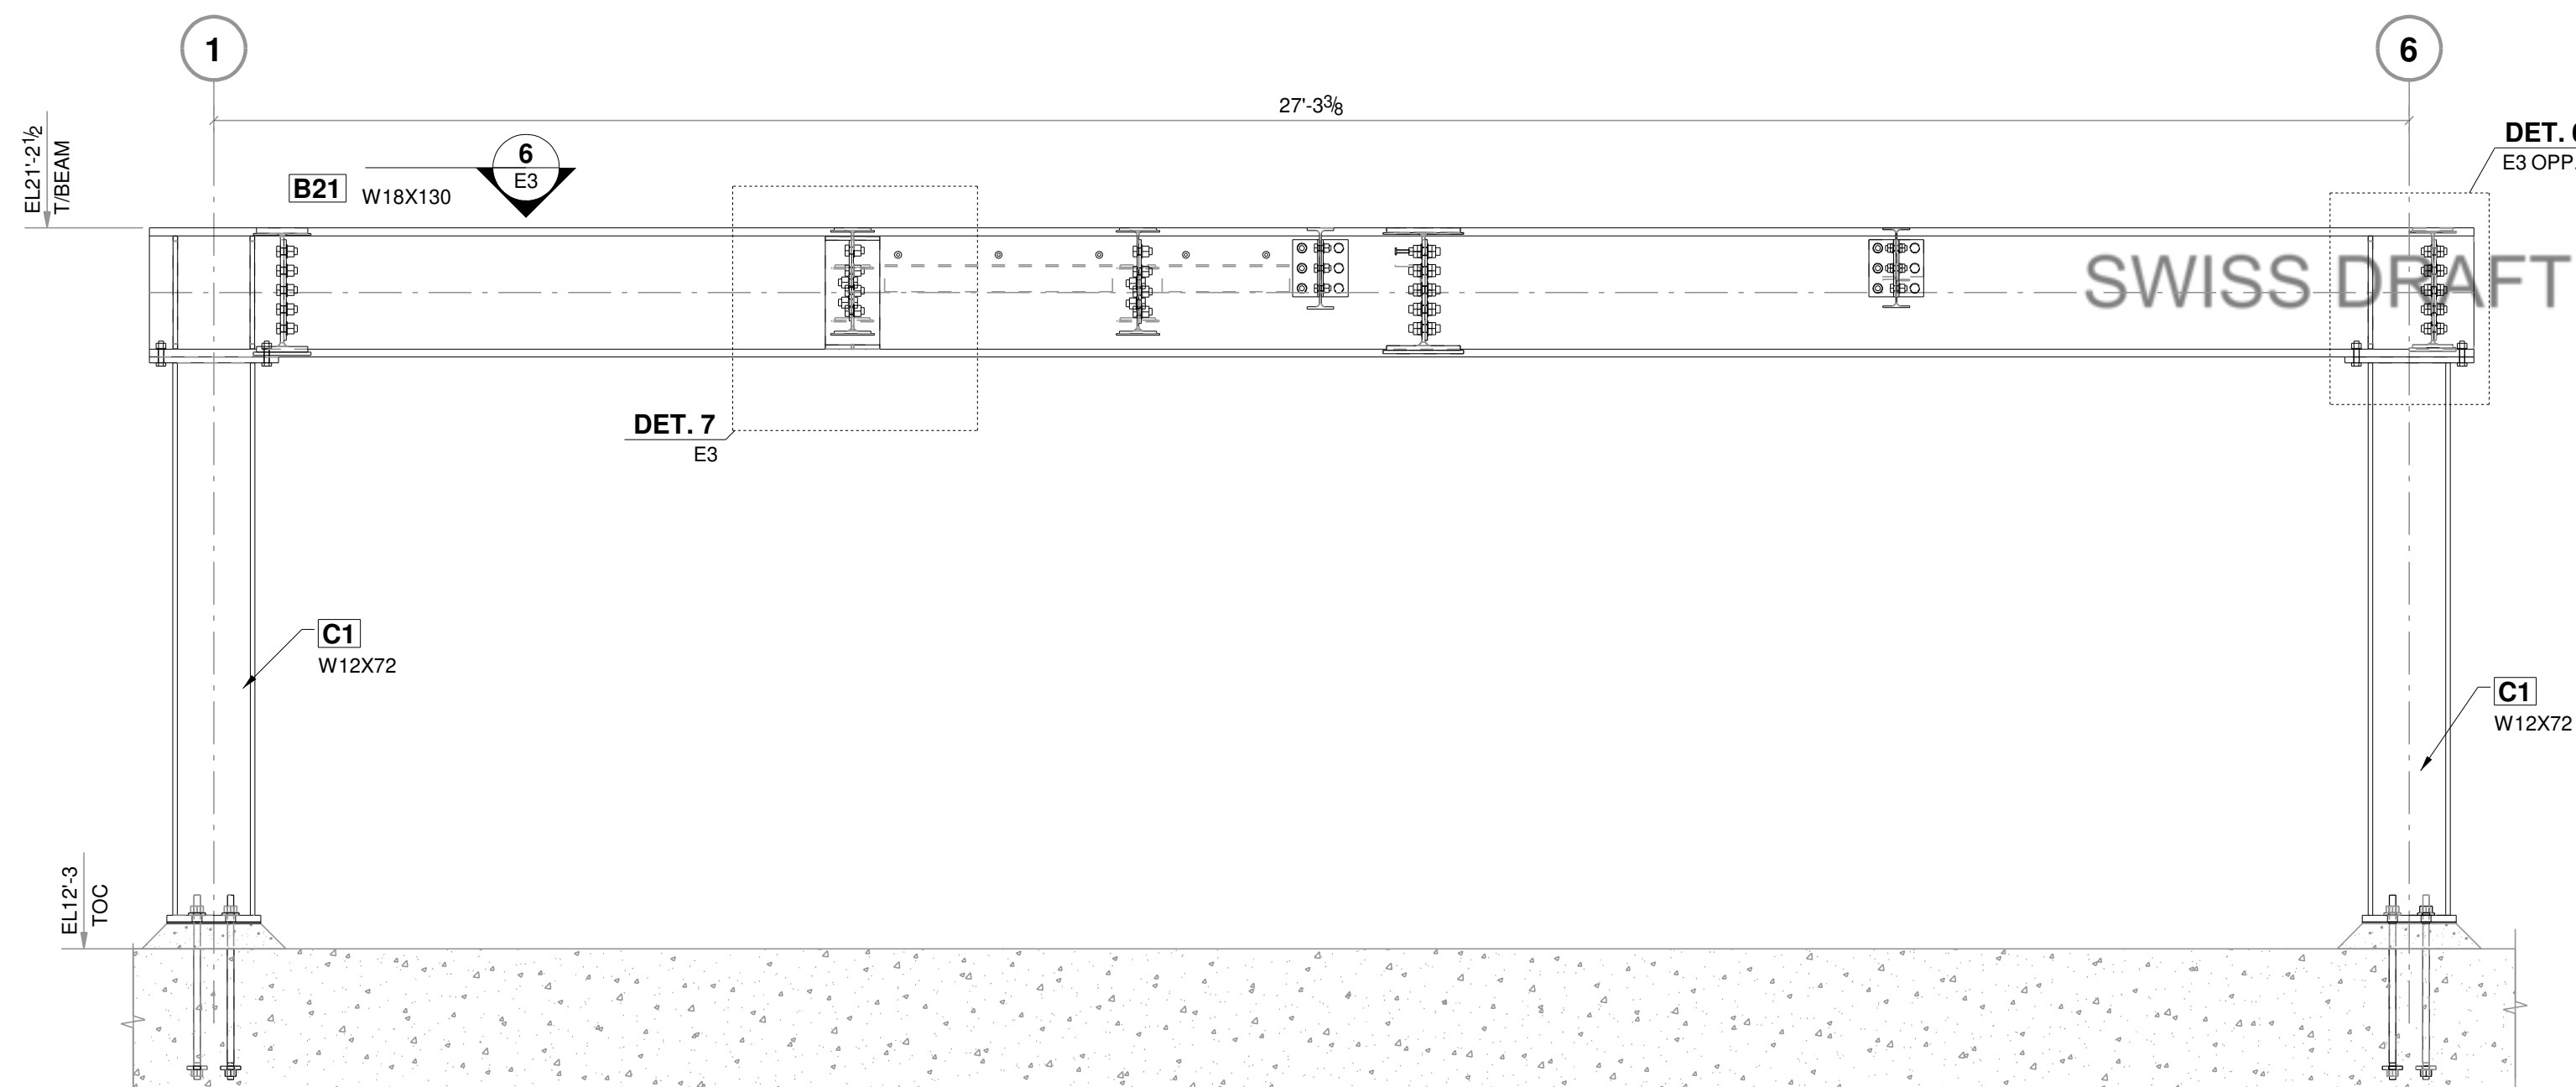


3 SECTION
REF: MF3/S201

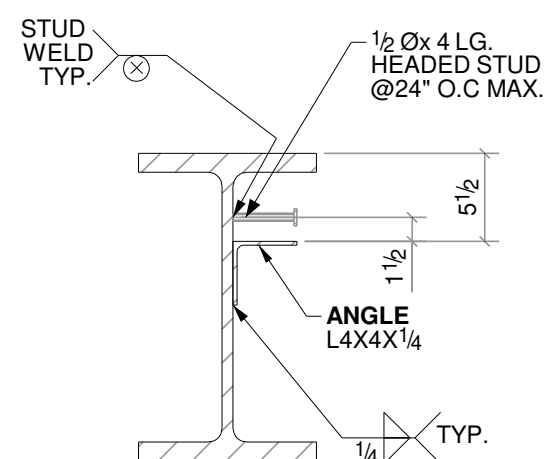


8 SECTION
REF.: 11/S-003


SWISS DRAFTING, CA (323)-286-0872

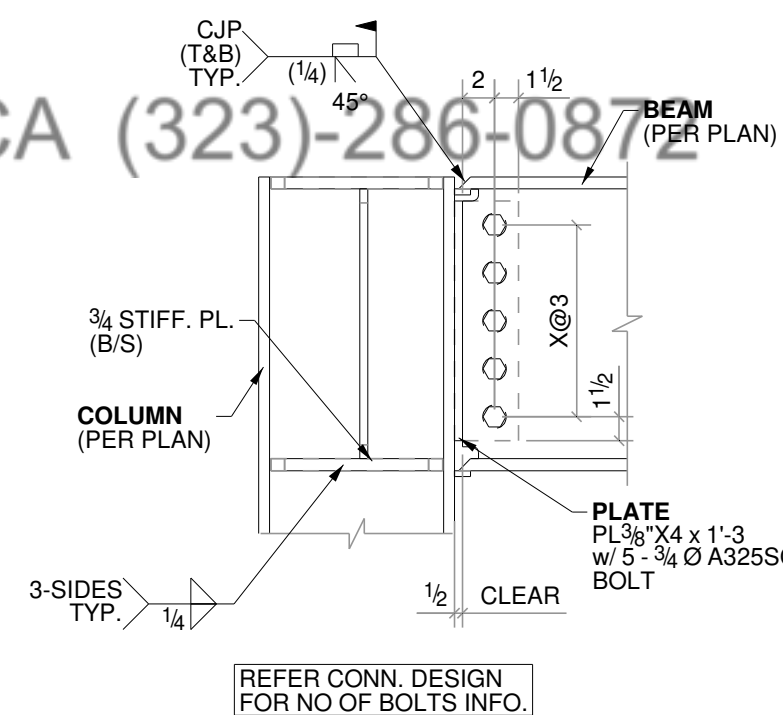


4 DETAIL
REFER CONN. DESIGN FOR NO. OF BOLTS INFO.

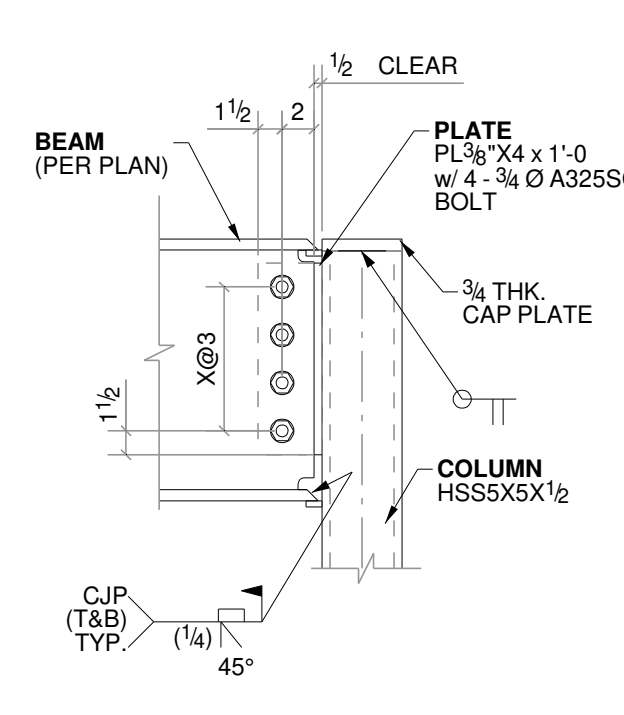


5 DETAIL
REFER CONN. DESIGN FOR NO. OF BOLTS INFO.

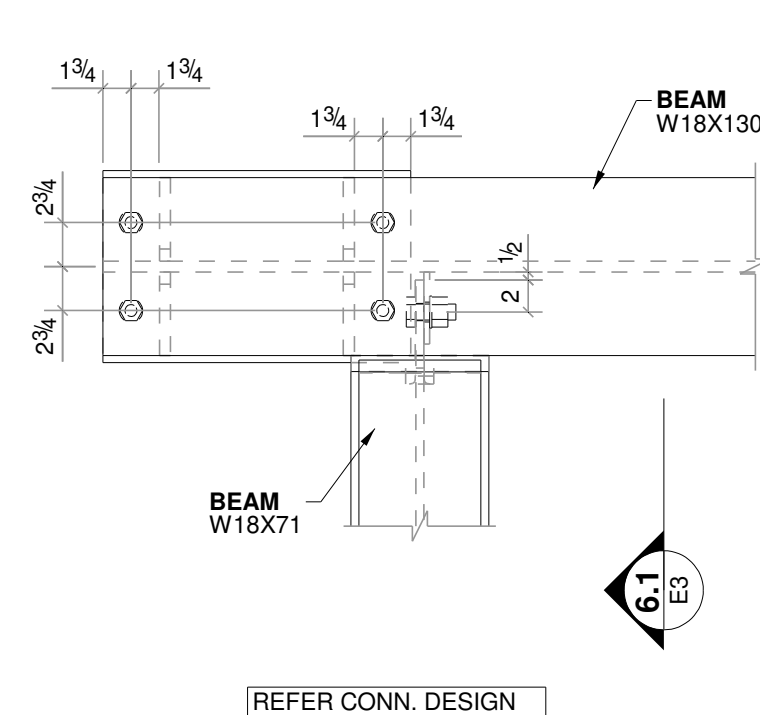


6 SECTION
REFER CONN. DESIGN FOR NO. OF BOLTS INFO.

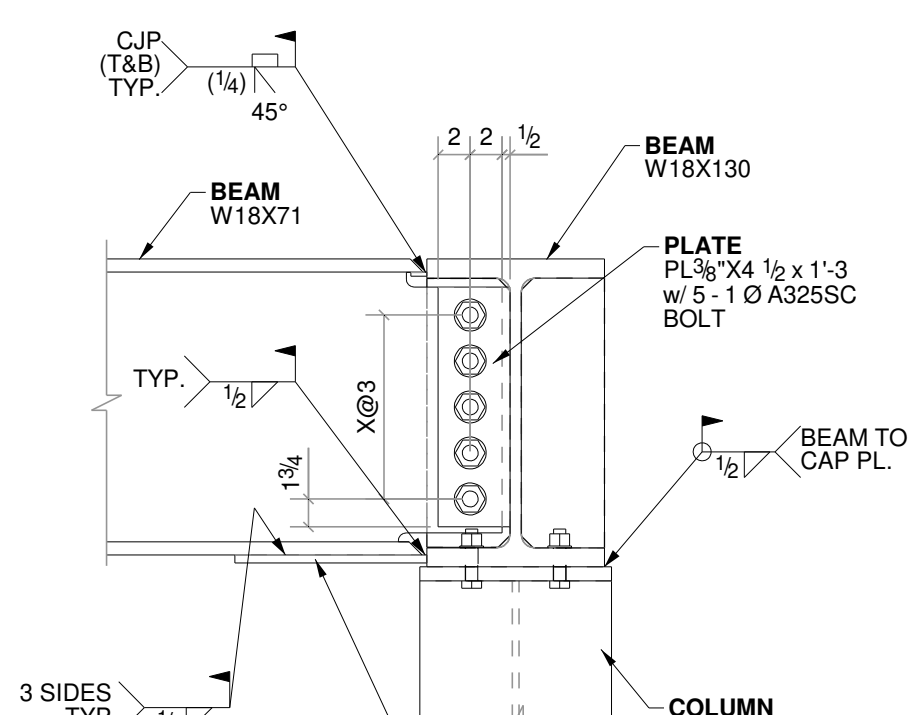

6.1 SECTION
REFER CONN. DESIGN FOR NO. OF BOLTS INFO.

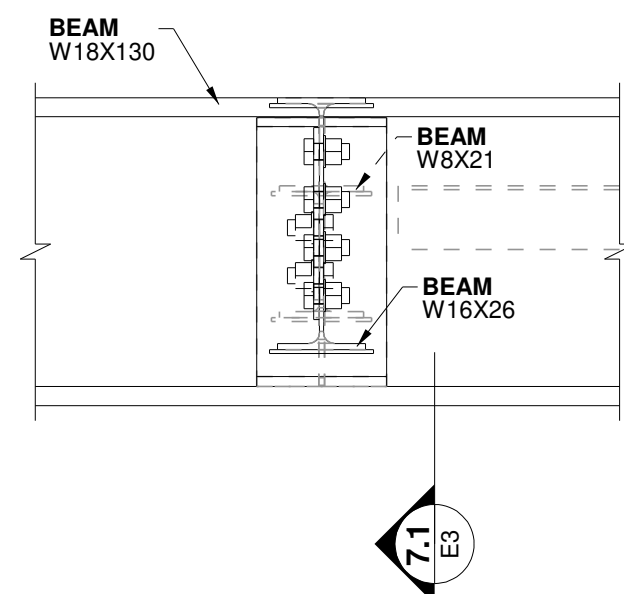

7 DETAIL
REFER CONN. DESIGN FOR NO. OF BOLTS INFO.

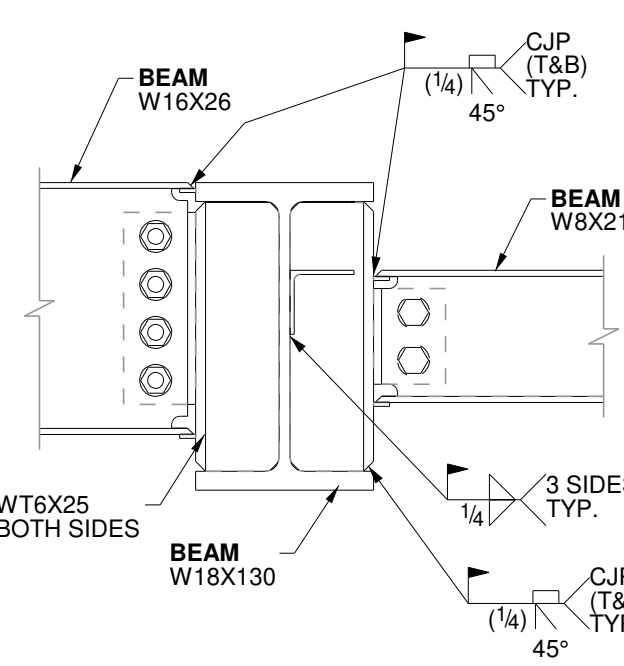

7.1 SECTION
REFER CONN. DESIGN FOR NO. OF BOLTS INFO.

2	03/12/2024	REVISED PER UPDATED SKS DATED 02/21/24
1	02/20/2024	REVISED PER MARKUPS DATED 01/26/24
0	12/21/2023	ISSUED FOR FIELD USE
B	12/08/2023	REVISED & REISSUED FOR APPROVAL PER MARKUPS
A	11/06/2023	ISSUED FOR APPROVAL

PROJECT NAME & LOCATION
22 WHITE STREET RESIDENCES
22 WHITE STREET CAMBRIDGE, MA

DWG. TITLE:
MOMENT FRAME SECTIONS

ENGINEER:
ARCHITECT: **KHALSA DESIGN INC.**

CONTRACTOR:

DRAWN BY: RH	CHK'D BY: AS	JOB NUMBER	DWG. NO.	REVISION
DATE: 10/29/2023	DATE: 11/03/2023	---	E3	2

FINISH: AS PER SPEC.
BOLT: A325N
HOLE SIZE: 13/16 DIA. UN
MATERIAL:
W SHAPES: A992-50
PIPS: A53, Gr. B
HSS SHAPES: A500, Gr. B
PLATES/CHANNELS: A36