
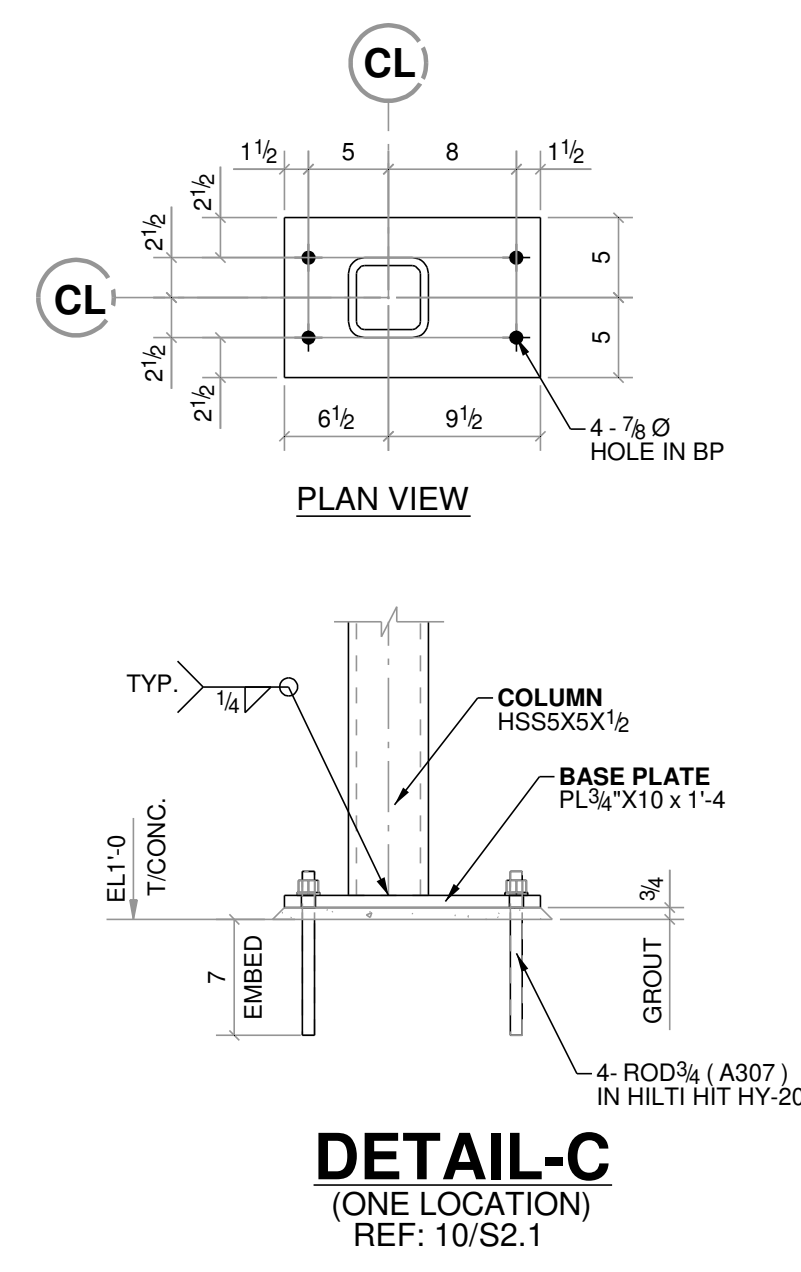
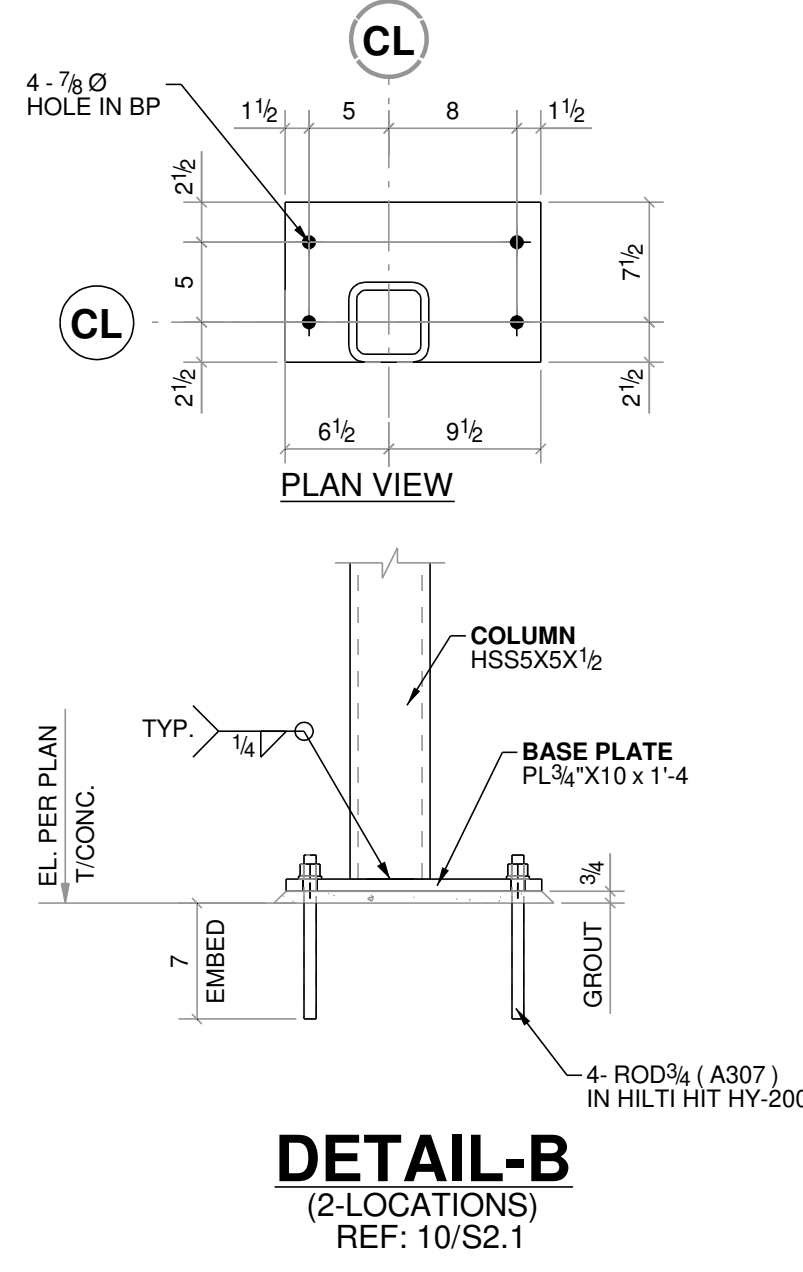
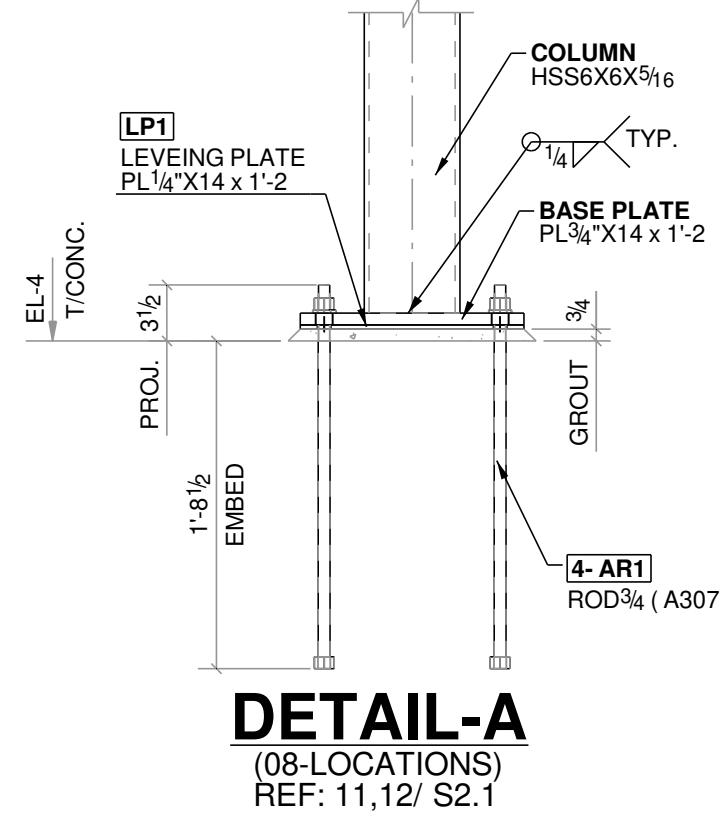
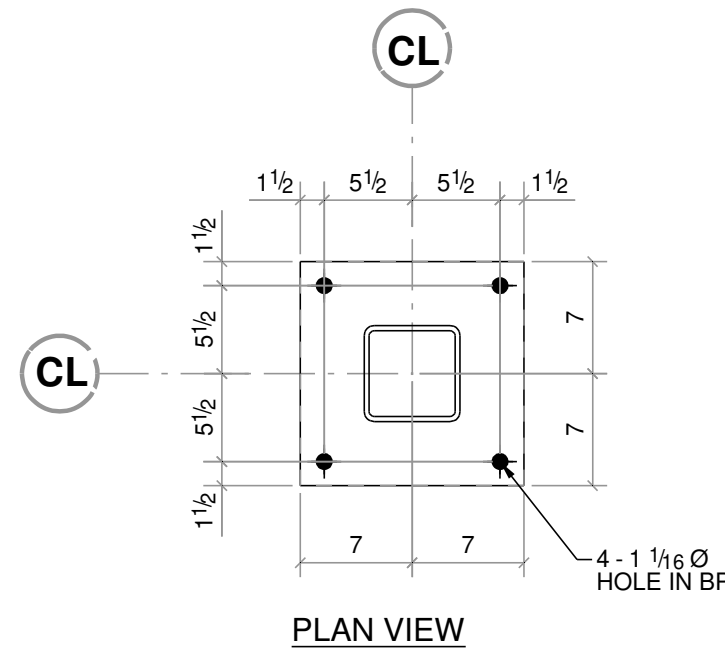


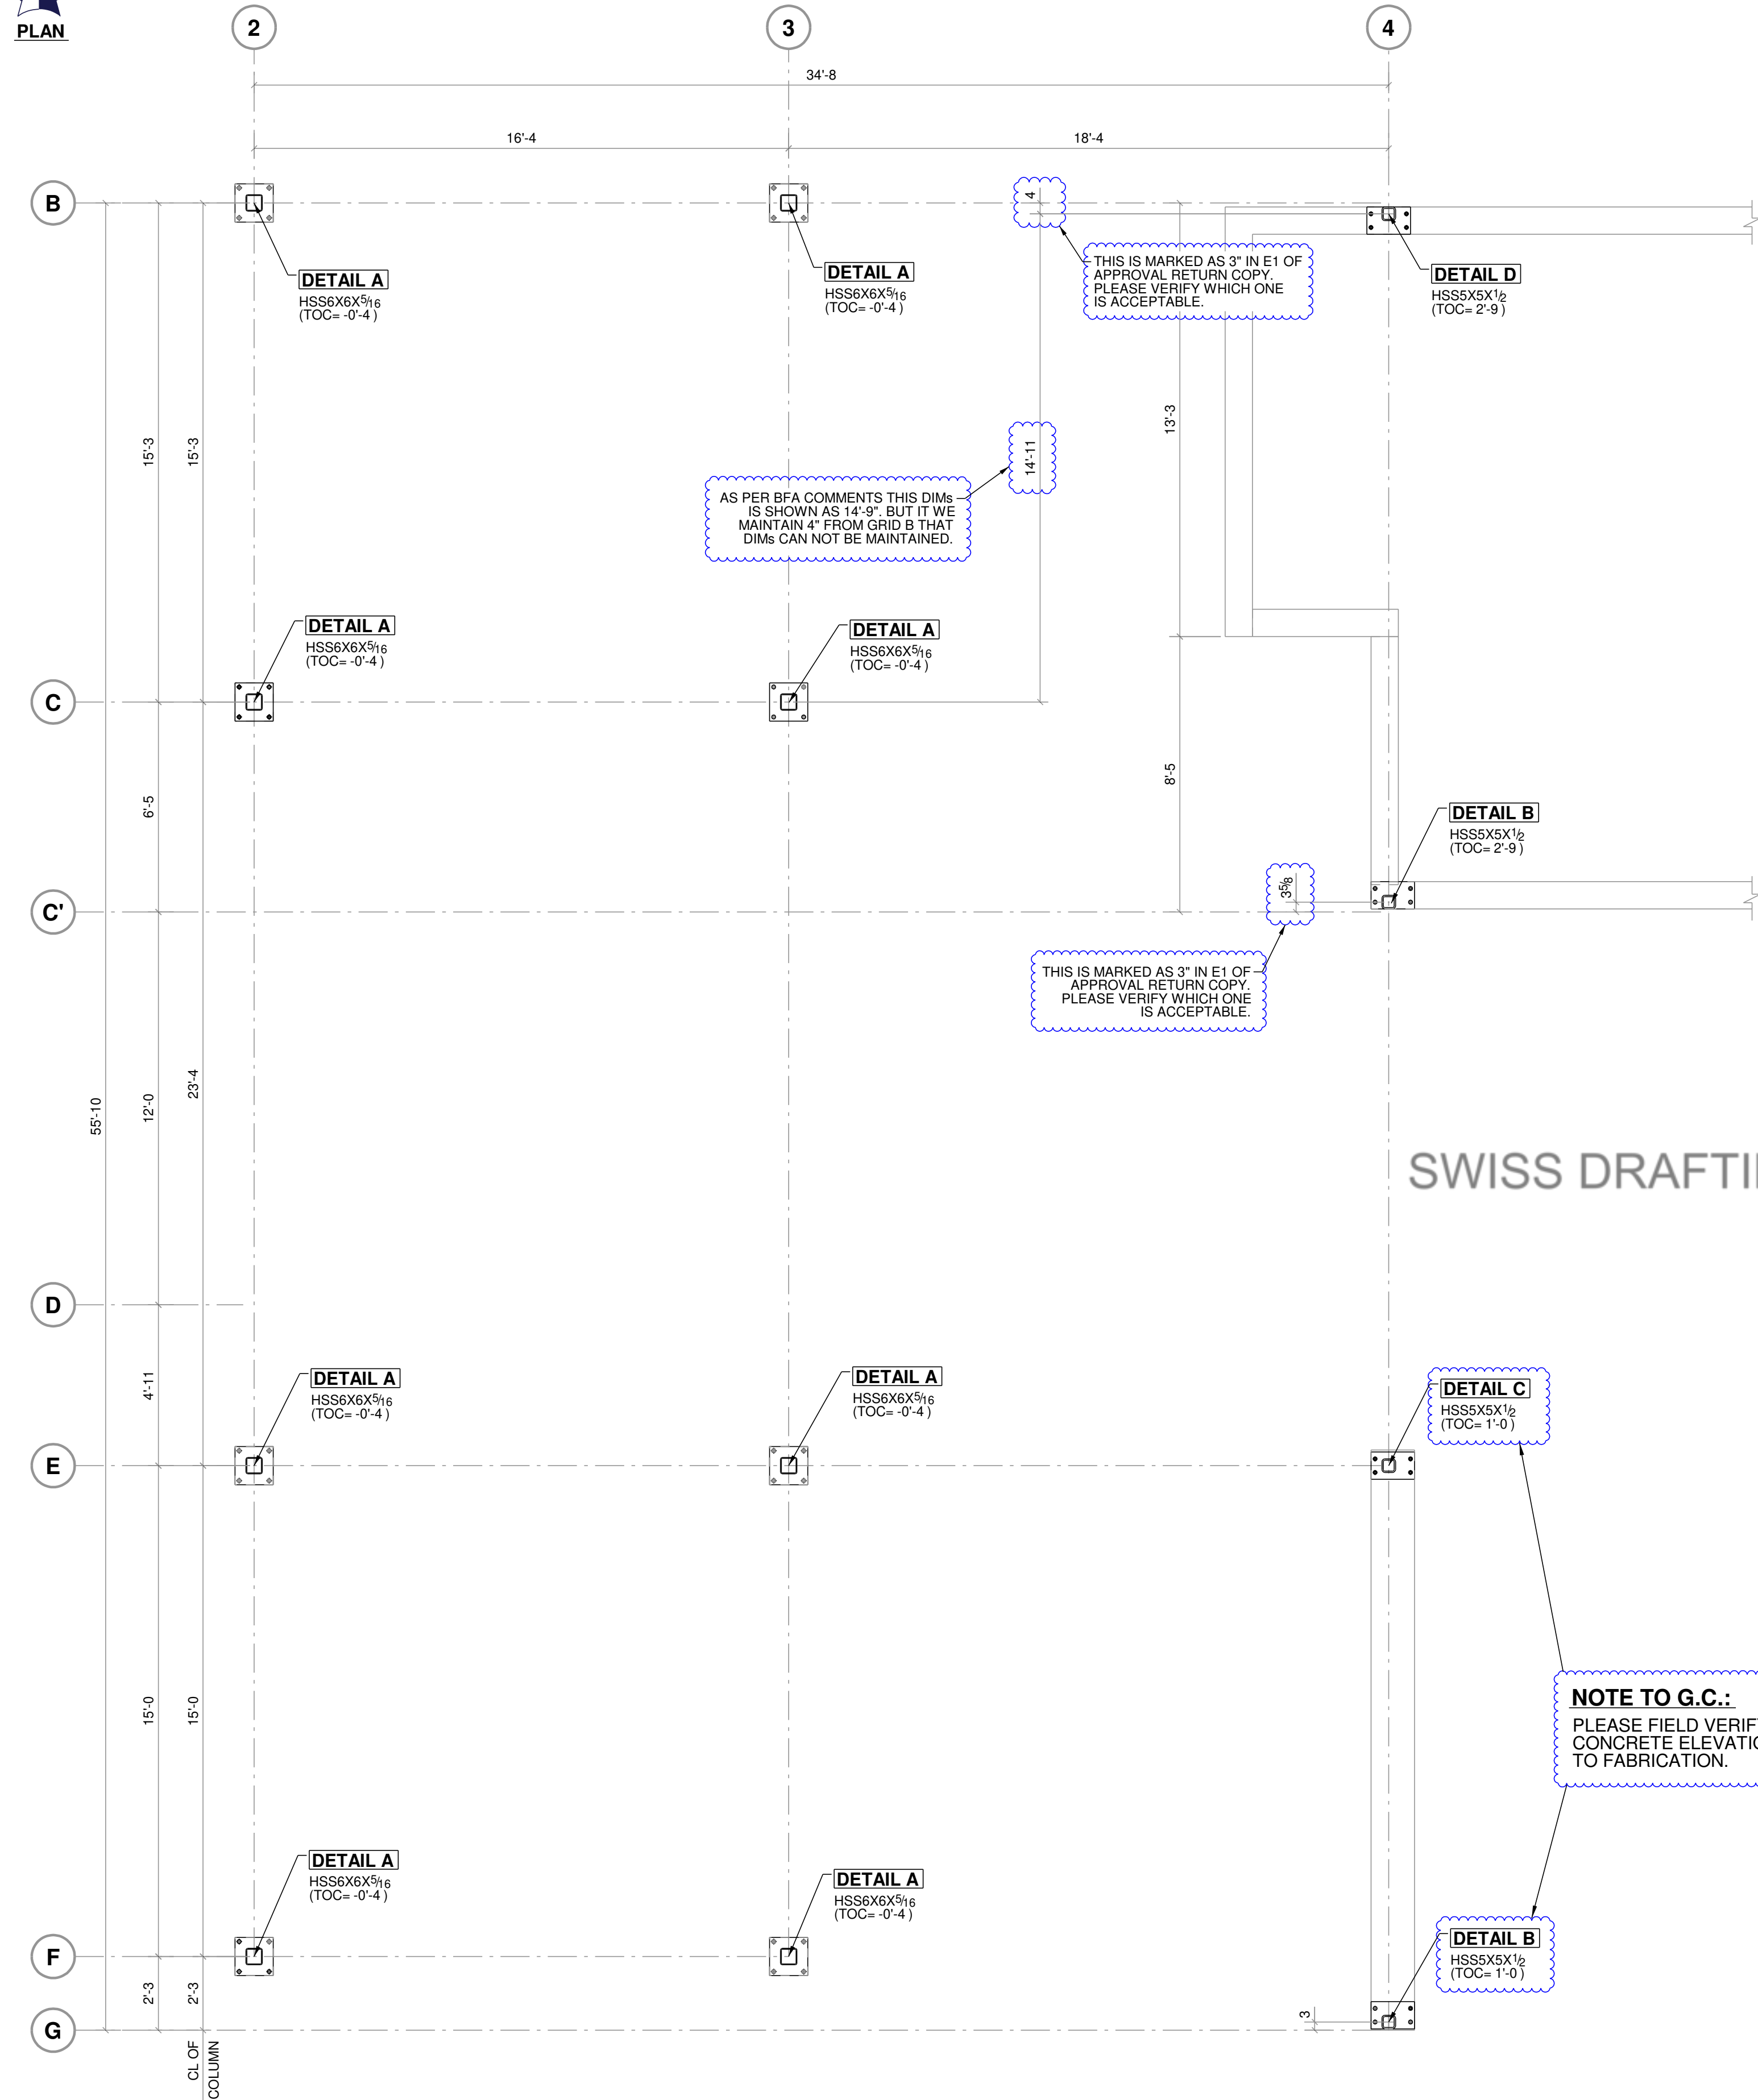

SWISS DRAFTING,CA (323)-286-0872

1 ANCHOR BOLT LAYOUT PLAN

REF: 1/ S1.1


GENERAL NOTE:

1. DATUM ELEVATION = FINISH FLOOR = 0'-0"
2. ALL ELEVATIONS ARE GIVEN FROM DATUM ELEVATION.
3. TOC = TOP OF CONCRETE ELEVATION = PER PLAN

NOTE TO APPROVER:
1. THESE DWGS ARE OUR INTERPRETATION OF CONTRACT DWGS & WILL BE ASSUMED TO BE CORRECT AS SHOWN UNLESS MARKED OTHERWISE ON THE APPROVAL DWGS.
2. ALL DIMENSIONS & ELEVATIONS SHOWN HERE NEEDS TO BE VERIFIED BY EOR/ ARCH AND WILL BE ASSUMED TO BE CORRECT AS SHOWN UNLESS MARKED OTHERWISE ON THE APPROVAL DWGS.


FINISH: AS PER SPEC.
BOLT: A325N
HOLE SIZE: 13/16 DIA. UN
MATERIAL:
W SHAPES: A992
PIPS: A53, Gr. B
HSS SHAPES: A500, Gr. B
PLATES/CHANNELS: A36

B	05/01/2023	REVISED PER MARKUPS
A	04/03/2023	ISSUED FOR APPROVAL
PROJECT NAME & LOCATION		
NEW MULTIFAMILY BUILDING FOR 95-97 ADDIS		
EAST BOSTON,MA 02128		
DWG. TITLE:		
ANCHOR BOLT LAYOUT PLAN		
ENGINEER: GREGORIAN ENGINEERS		
ARCHITECT: SANGIOLO ASSOCIATES ARCHITECTS		
CONTRACTOR:		
DRAWN BY: RH	CHK'D BY: AS	JOB NUMBER
DATE: 03/27/2023	DATE: 03/31/2023	---
DWG. NO.		REVISION
AB1		B

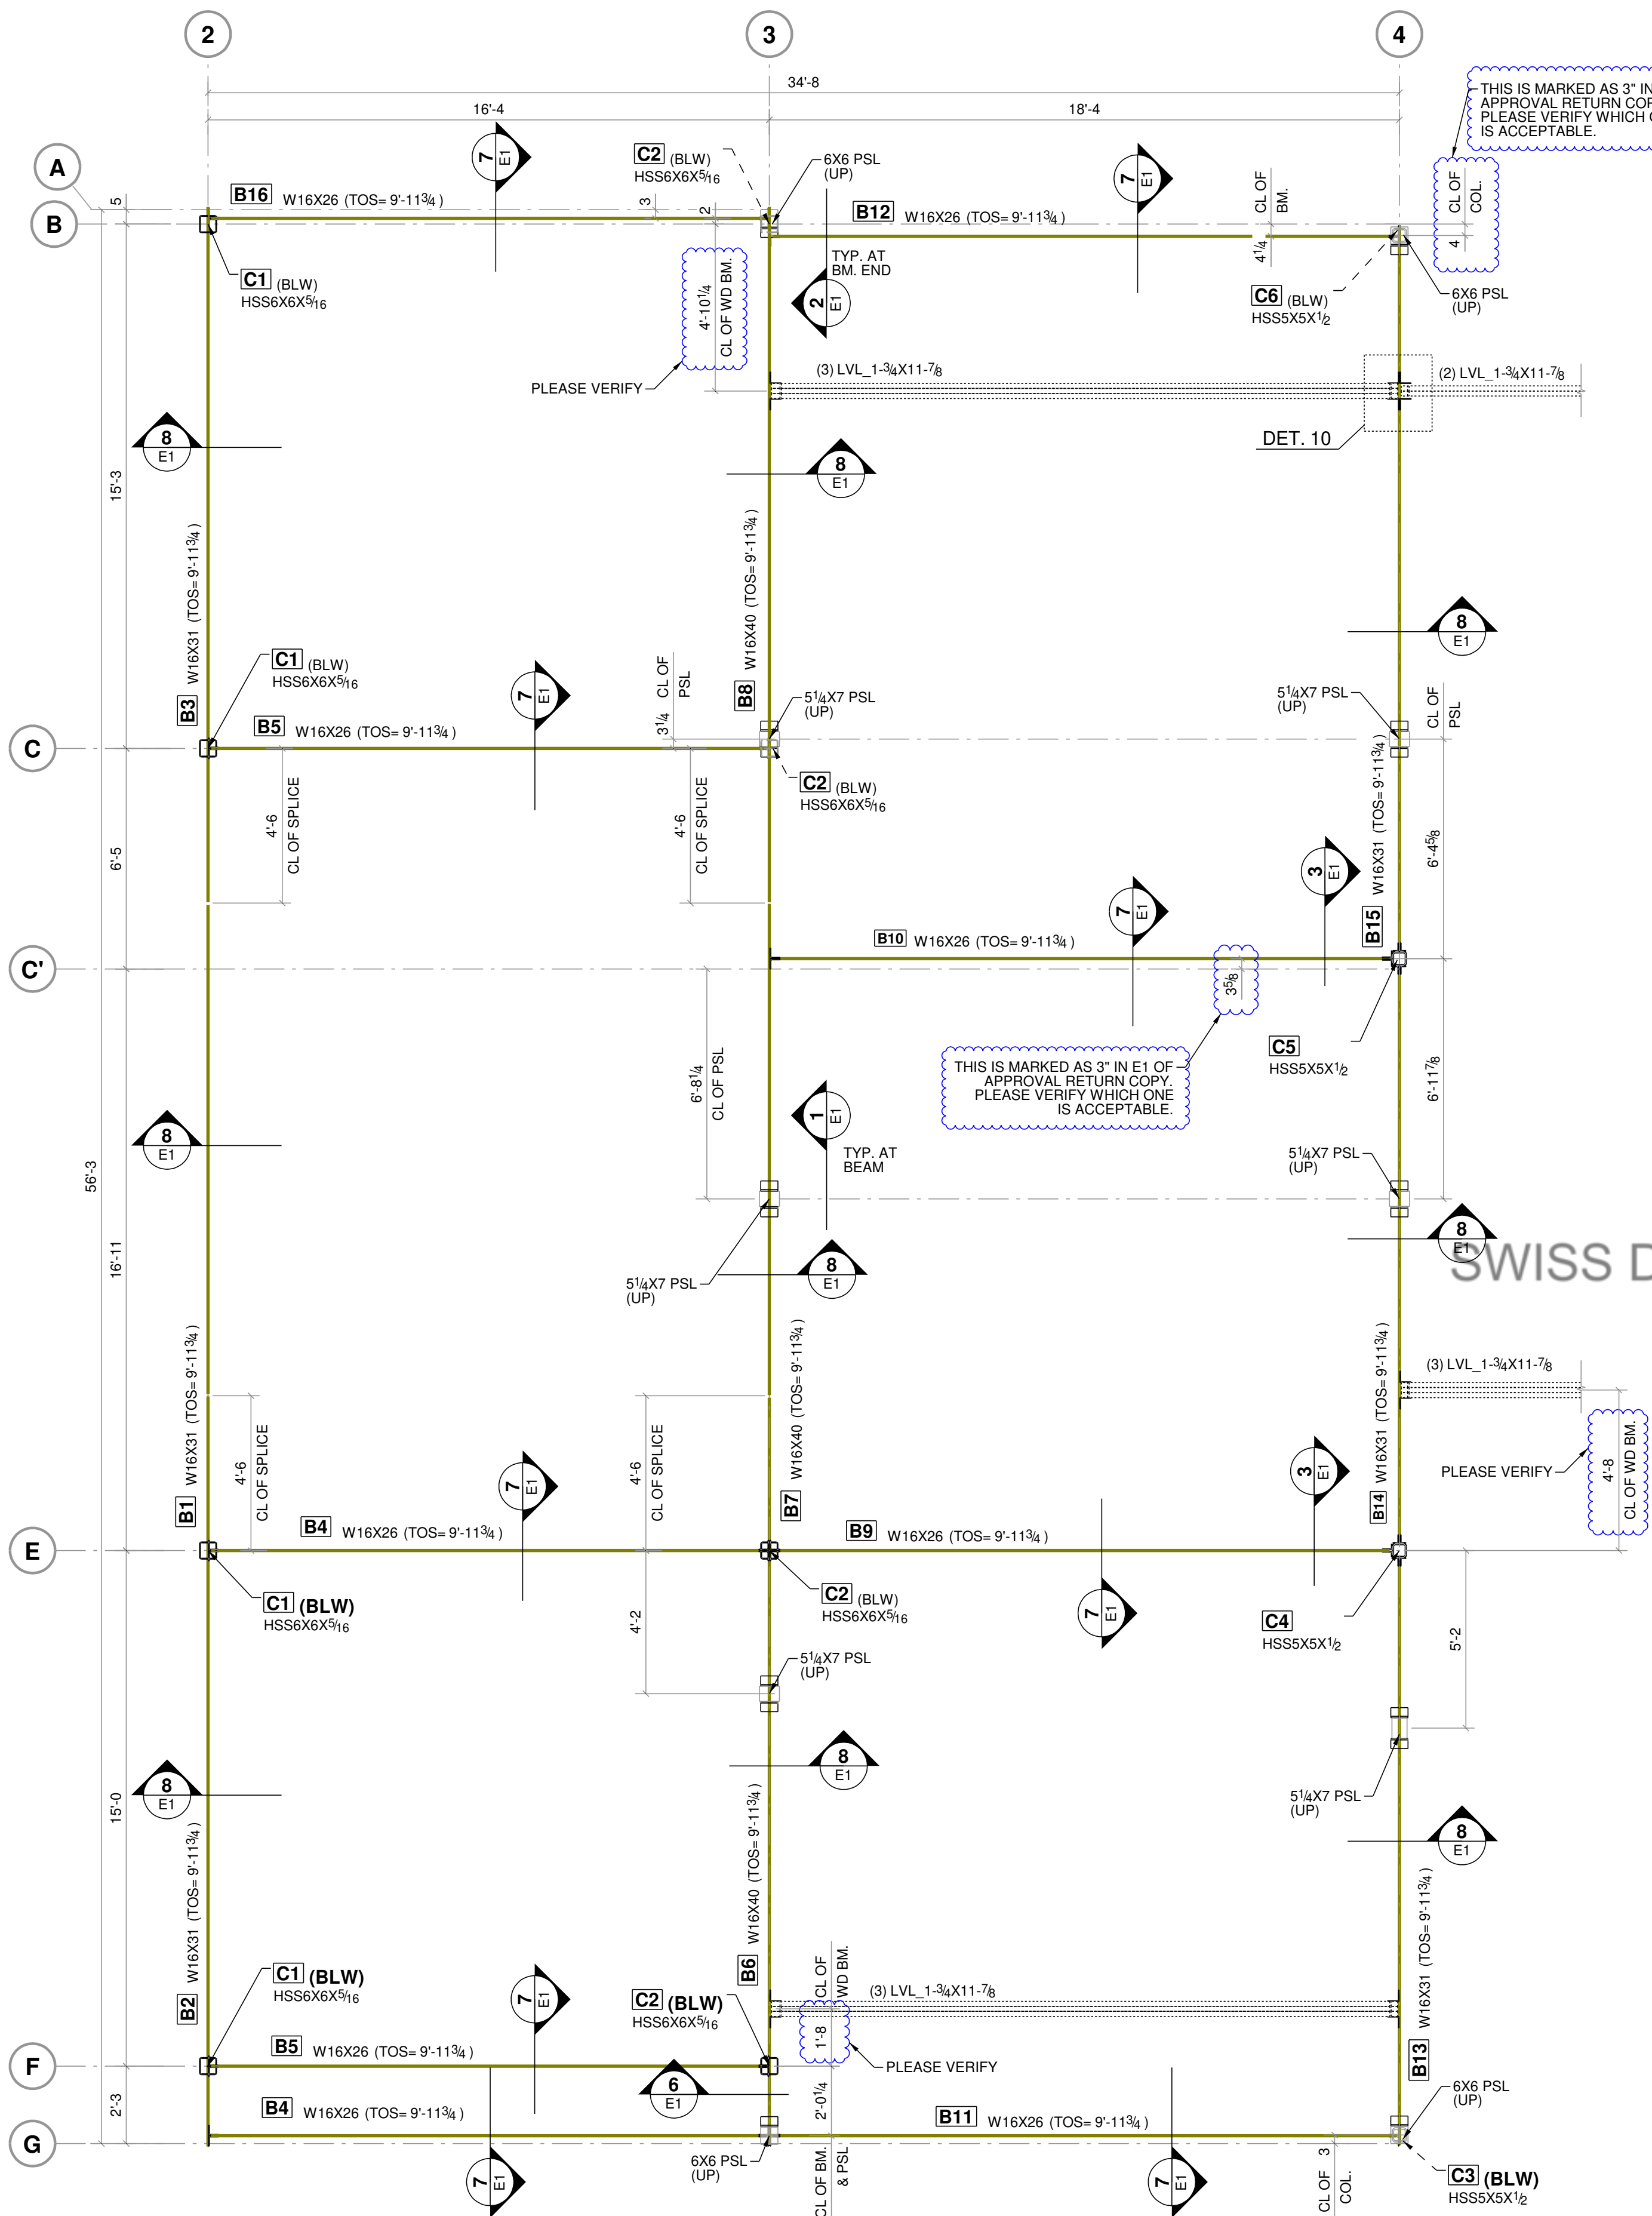

1 SECOND FLOOR FRAMING PLAN
REF: 1/ S1.2

GENERAL NOTE:
1. DATUM ELEVATION = FINISH FLOOR - 0'-0"
2. ALL ELEVATIONS ARE GIVEN FROM DATUM ELEVATION.
3. ALL WOODEN POST AND BEAMS ARE BY OTHERS.

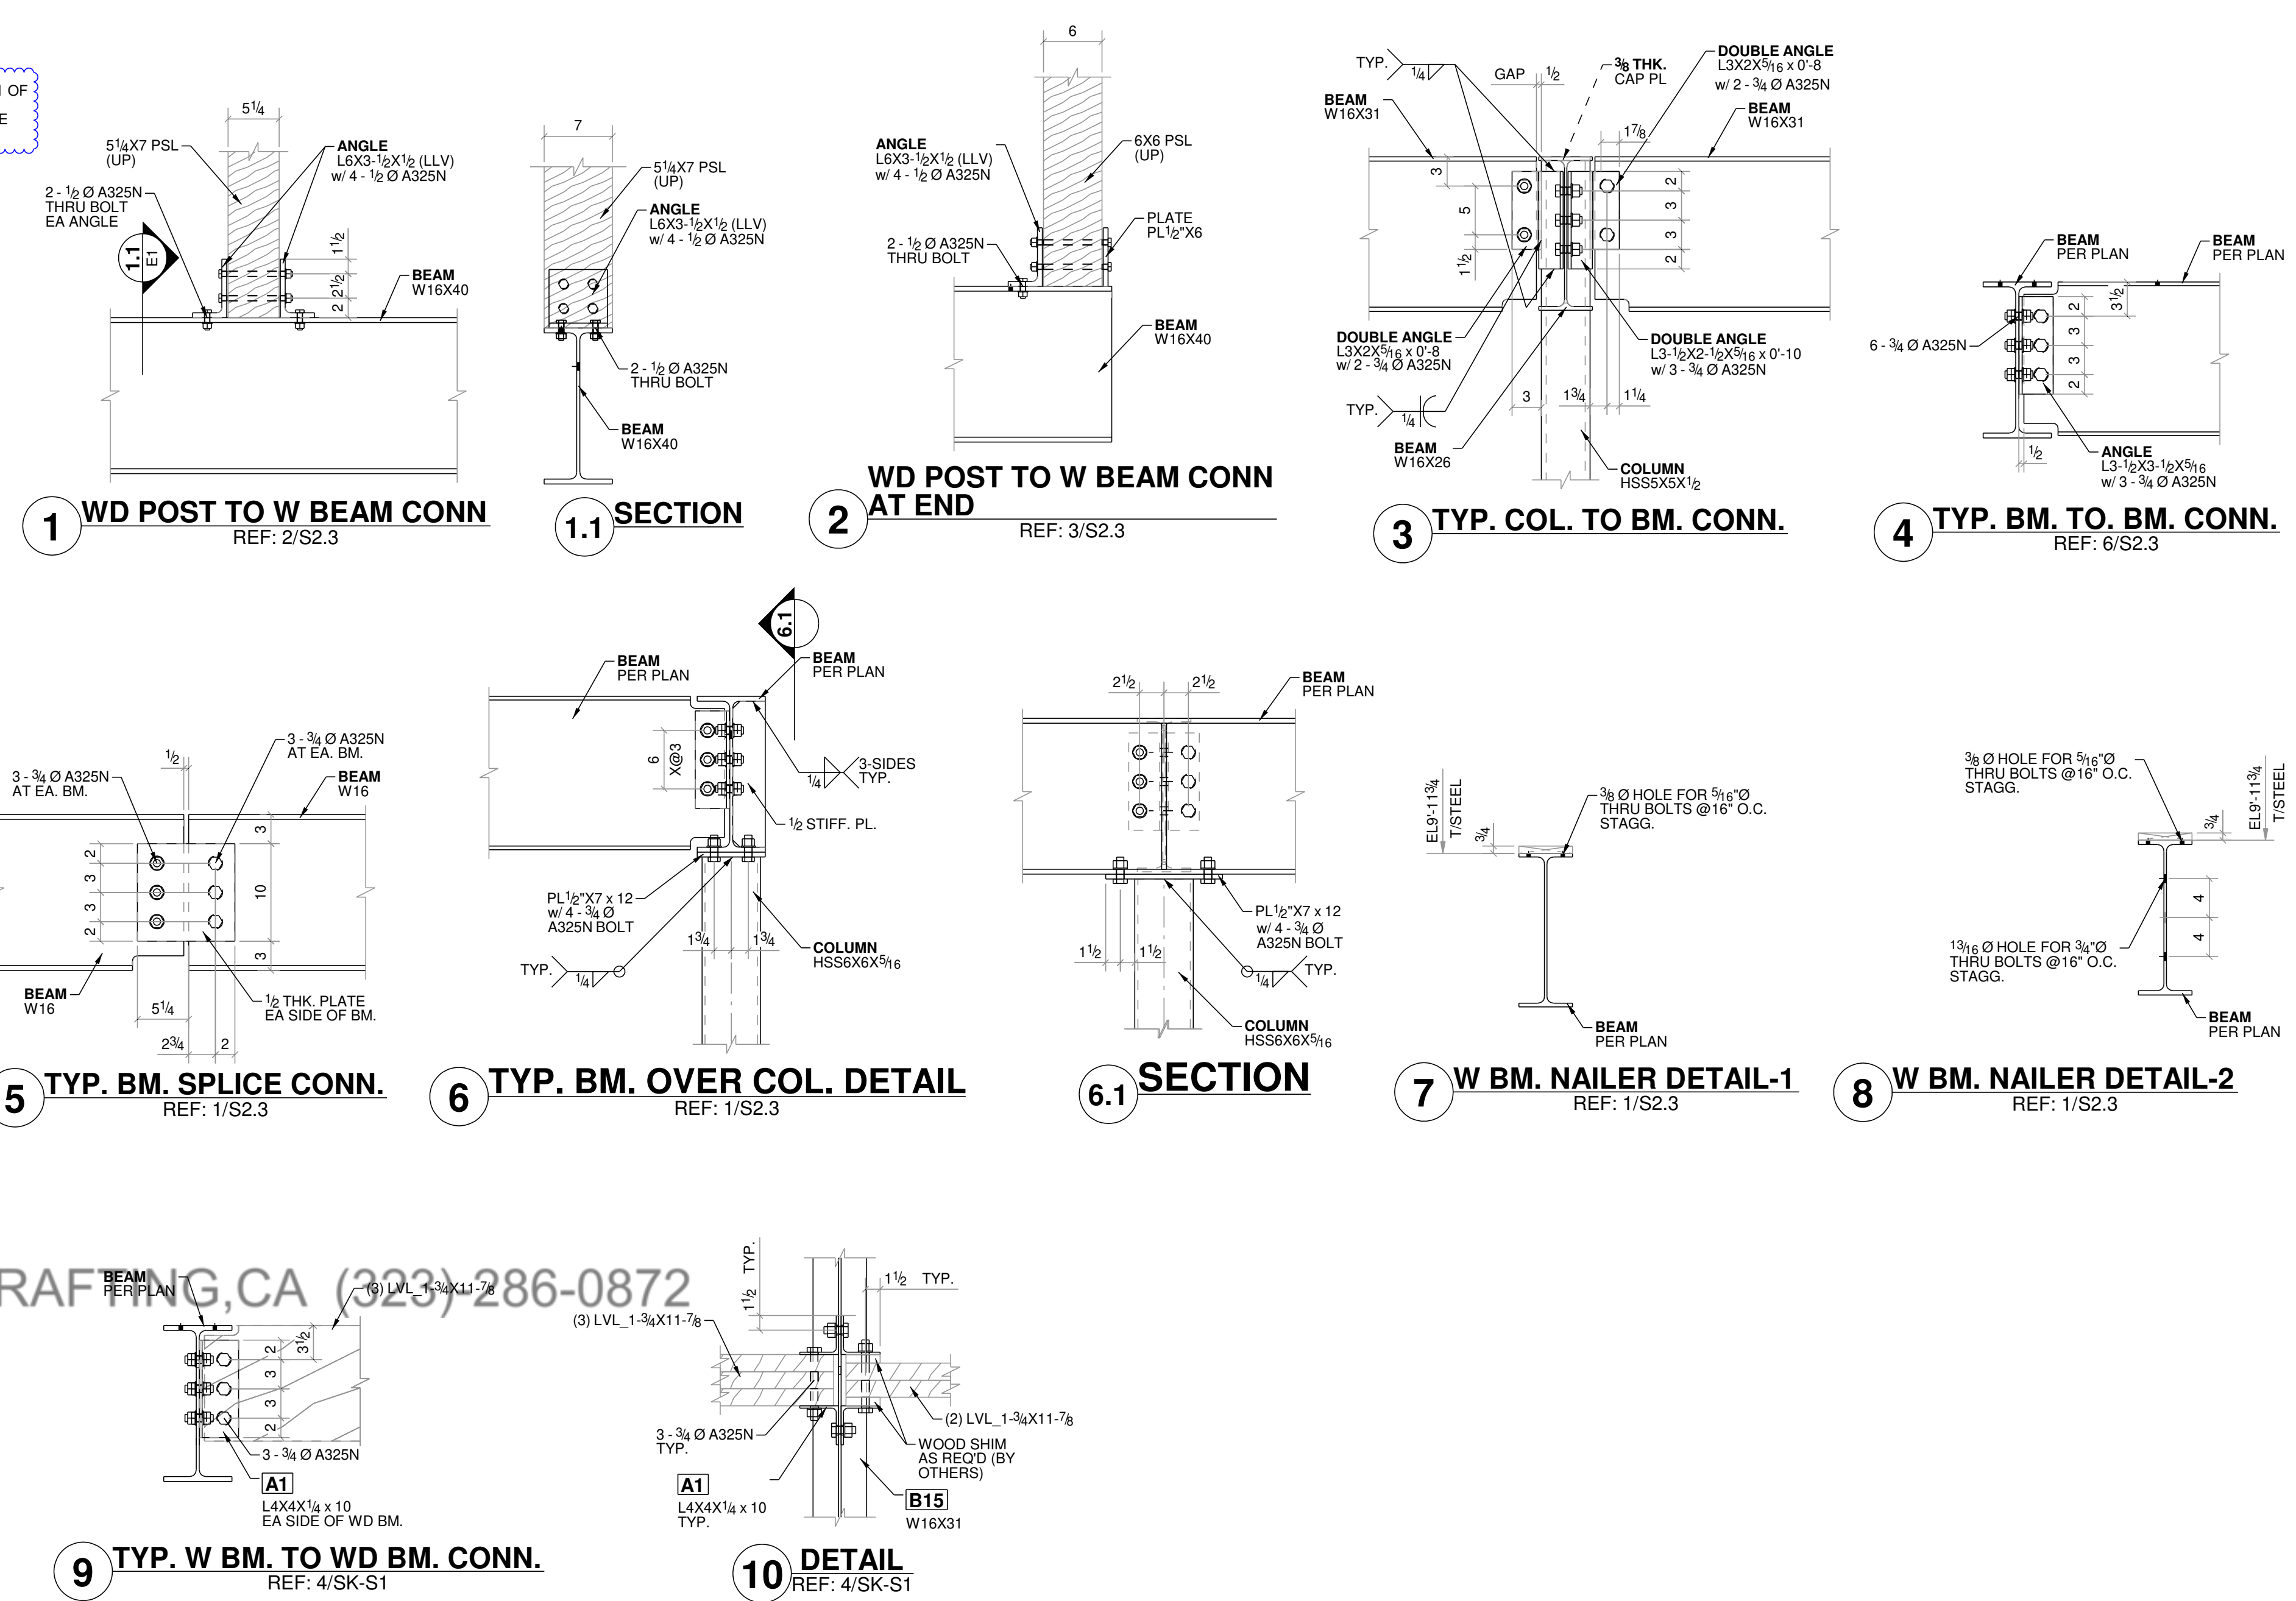

NOTE TO APPROVER:
1. THESE DWGS ARE OUR INTERPRETATION OF CONTRACT DWGS & WILL BE ASSUMED TO BE CORRECT AS SHOWN UNLESS MARKED OTHERWISE ON THE APPROVAL DWGS.
2. ALL DIMENSIONS & ELEVATIONS SHOWN HERE NEEDS TO BE VERIFIED BY EOR/ ARCH AND WILL BE ASSUMED TO BE CORRECT AS SHOWN UNLESS MARKED OTHERWISE ON THE APPROVAL DWGS.

FINISH:	AS PER SPEC.
BOLT:	A325N
HOLE SIZE:	13/16 DIA. U/N
MATERIAL:	
W SHAPES:	A992
PIPS:	A53, Gr. B
HSS SHAPES:	A500, Gr. B
PLATES/CHANNELS:	A36

B	05/01/2023	REVISED PER MARKUPS
A	04/03/2023	ISSUED FOR APPROVAL
PROJECT NAME & LOCATION		
NEW MULTIFAMILY BUILDING FOR 95-97 ADDIS		
EAST BOSTON, MA 02128		
DWG. TITLE:		
SECOND FLOOR FRAMING PLAN		
ENGINEER:		
GREGORIAN ENGINEERS		
ARCHITECT:		
SANGIOLO ASSOCIATES ARCHITECTS		
CONTRACTOR:		
DRAWN BY: RH	CHK'D BY: AS	JOB NUMBER
DATE: 03/27/2023	DATE: 03/31/2023	---
DWG. NO.		REVISION
E1		B